



Saline

KANSAS ✓

Sec. 30 Twp. 15 R. 3W

Well No. #3 Larson Farm

Geo. Learci Company

E. K. Carey - Contr. Contractor

Smolin


1320' Ft. from N. Line

Ft. from S. Line

Ft. from E. Line

330' Ft. from W. Line

C W/2 W/2 NE

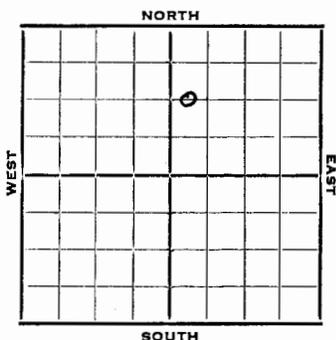


KANSAS

FORM 51 25M 3-49 PETROL Saline

Section 30 Township 15 Range 3W

Well No. #3 Larson

Company Geo. Searci

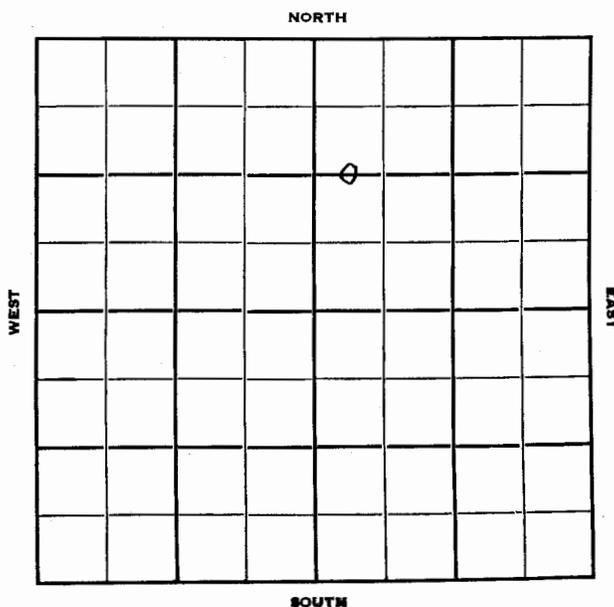

1952	Elev. 1286'	REPORT
4/16	MIR	
4/23	8" @ 348'	
4/30	Anhy 340'	KC 2248
	Miss 2842	
	Drilg. 3010'	
5/7	KH 3174' Htn 3302' Mq shale 3314'	
	Mq Dol 3395' RTD 3400' 5" @ 3395'	
5/14	DP	
5/21	CO 3400' B/some oil 1000A	
	S/3½ BO 1 hr. Fill up 500' oil	
	plus 250' A wtr. overnight	
5/28	NR	
6/11	NR	
6/18	S/3½ BOPH for 4 hrs. POP	
6/25	NR	
7/2	NR	
7/9	Spud 4-19-52	
	Oil well TD 3400 8" @ 348	
	Anhy 340' KC 2248' Miss 2842'	
	Kh. 3174' Hunton 3302' Maq. sh.	
	3314' Maq. dol. 3395'	
	TD 3400' 5" @ 3395' CO to 3400	
	B/some oil 1000 A S/3½ BO FU 500'	
	oil, 250' acid water overnite	
	S/3½ BOPH	
	Comp. 86 BOPD	
	<b>COMPLETED</b>	