

County **Saline** State **Kansas**

Sec. **30** (Blk. Twp.) **15** (Sur. Rge.) **3W** Map No.

Operator **Geo. Sercl**

Well No. **1** Farm **Larson**

Elev. Location **NW NW NE**

330 Ft. From **N** Line **NE**

330 Ft. From **W** Line **Quarter**

1st. Report **OCT 25 1950**

Completion

Remarks **Carey Drlg. - Contr.**

Spudding Date

Drig. Data

Location

J. E. TYRA

County **Saline** State **Kansas**

Sec. **30** (Blk. Twp.) **15** (Sur. Rge.) **3W** Map No.

Operator **Geo. Sercl**

Well No. **1** Farm **Larson**

Elev. **1282** Location **NE NW NE**

330 Ft. From **N** Line **NE**

330 Ft. From **W** Line **Quarter**

1st. Report

Completion **DEC 13 1950**

Remarks

Carey - Contr.

Spudding Date **11-1-50**

Drig. Data Oil well TD 3385

3" c 309 Lens, 2214 B KC 2560

Cherokee 2708 Miss. 2840 Kinderhook

3158 Misener 3288 Hunton 3294

14q. sh. 3318 14q. dol. 3381 TD 3385

5" c 3381 FU 700' oil 16 hr.

S/ 27 bopd Comp. 28 bopd

J. E. TYRA

Saline KANSAS

Sec. 30 Twp. 15 R. 3W

Well No. #1 Larson Farm

Geo. Sercl Company

Carey Drlg. Contr. Contractor


330' Ft. from N. Line

_____ Ft. from S. Line

_____ Ft. from E. Line

330' Ft. from W. Line

NW NW NE

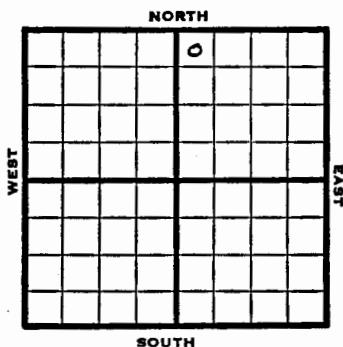

1950 Elev. 1282' **REPORT**

10/25 Location
12/13 Spud 11-1-50
Oil Well TD 3385
8" @ 309' Lans. 2214
BKC 2560' Cherokee 2708
Miss 2840' Kinderhook 3158'
Misener 3288' Hunton 3294
Maq sh 3318 Maq dol. 3381
TD 3385 5" @ 3381 FU 700' oil 16 hr
FU 700' oil 16 hr.
S/27 bopd Comp. 28 bopd

COMPLETED

KANSAS

Saline

Section 30 Township 15 Range 3W

Well No. #1 Larson

Company Geo. Sercl

