

County Saline State Kansas

Sec. 30 (Bk.) 15 (Sur.) 3W Map No.
(Twp.) (Rge.)

Operator Johnson Bros.

Well No. 1 Farm Larson

Elev. 1285 Location NE NE NW

430 Ft. From N Line NW

330 Ft. From E Line Quarter

1st. Report

Completion FEB 21 1951

Remarks Smolen Pool

Carey Drlg. - Contr.

Spudding Date 1-23-50

Drig. Data Oil well TD 3387

12" @ 150 8" @ 295 Miss. 2841
Kinderhook 3154 Misenor 3290 Hunton 3292
 Maq. 3316 Dol. 3382 DST 3382-87
open 1 hr. Rec. 600' oil 155' ocm
 5" @ 3382 S/ 30 bo Comp. 363 bopd

J. E. TYRA

E. TYRA

Saline

KANSAS

Sec. 30 Twp. 15 R. 3W ✓

Well No. #1 Larson Farm

Johnson Bros. Company

Carey Drlg. - Contr. Contractor

Smolen Pool


430' Ft. from N. Line

Ft. from S. Line

330' Ft. from E. Line

Ft. from W. Line

NE NE NW

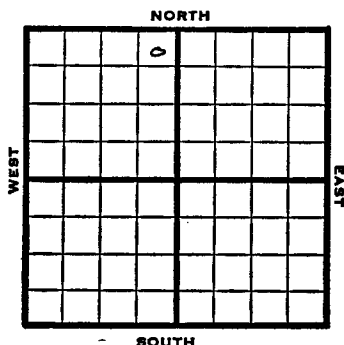

1950 Elev. 1285' REPORT

11/22 RUR

1951
2/21 Spud 1-23-50
Oil well TD 3387
12" @150 8" @295
Miss. 2841 Kinderhook 3154
Misenor 3290 Hunton 3292
Maq. 3316 Dol. 3382
DST 3382-87 open 1 hr. rec. 600' oil
155' OCM
5" @3382 S/ 30 bo
Comp. 363 bopd
COMPLETED

Saline

KANSAS

Section 30 Township 15 Range 3W

Well No. #1 Larson

Company Johnson Bros.

