

County Saline State Kansas
 Sec. 30 (Blk. 15 (Sur. 3W) Map No.
 Operator Republic Natural
 Well No. 5 Farm Larson
 Elev. _____ Location C E $\frac{1}{2}$ E $\frac{1}{2}$ NW

1320 Ft. From N Line NW
330 Ft. From E Line Quarter
 Ist. Report JAN 21 1953
 Completion _____
 Remarks _____
 Spudding Date 1-16-53

Drig. Data _____
8" @ 315 drlg. 500

J. G. McGEHEE

County Saline State Kansas
 Sec. 30 (Blk. 15 (Sur. 3W) Map No.
 Operator Republic Natural Gas
 Well No. 5 Farm Larson
 Elev. 1287 Location C E $\frac{1}{2}$ E $\frac{1}{2}$ NW

1320 Ft. From N Line NW
330 Ft. From E Line Quarter
 Ist. Report _____
 Completion FEB 25 1953
 Remarks _____
 Spudding Date 1-16-53

Drig. Data Oil well TD 3440
8" @ 315 Miss. 2864 Kh. 3167
Misener 3296 Hunton 3303 Mag. sh. 3324
Viola 3390 TD 3440 5" @ 3440
6/ 3394-98 1000 A S/ 8 bo 1 hr.
S/ 30 bo 5 hr. Comp. 120 bopd

J. G. McGEHEE

Saline **KANSAS** ✓

Sec. 30 Twp. 15 R. 3W

Well No. #5 Larson Farm

Republic Natural Company

Contractor


1320 Ft. from N. Line

Ft. from S. Line

330 Ft. from E. Line

Ft. from W. Line

C E $\frac{1}{2}$ E $\frac{1}{2}$ NW

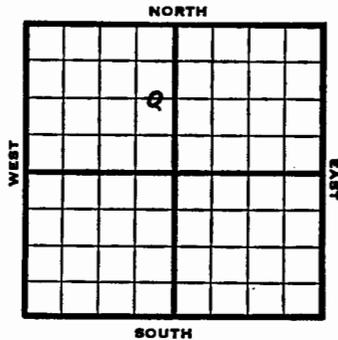


KANSAS

Section 30 Township 15 Range 3W

Well No. 5 Larson

Company Republic Natural

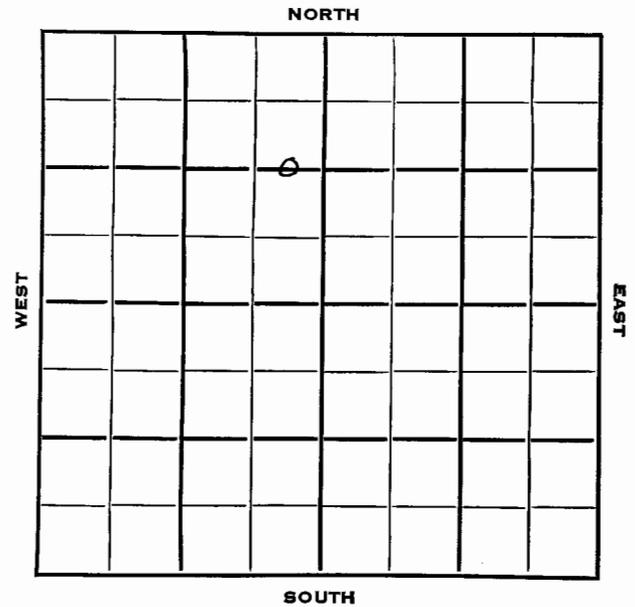

1953 Elev. 1287' REPORT

1/21 Spud 1-16-53
8" @ 315
Drlg. 500

1/29 Drlg. 2055'

2/5 Drlg. 3190'

2/12 V 3390' TD 3440' 5" @ 3440
6/3394-98 1000 A S/8 BO 1 hr.

2/19 S/30 BO 5 hrs. Miss 2864'
KH 3167' Meisner 3296' Htn 3303
Mq. shale 3324'

2/25 Spud 1-16-53
Oil well TD 3440' 8" @ 315
Miss 2864' Kh. 3167' Misener 3296
Hunton 3303 Maq. sh. 3324
Viola 3390 TD 3440 5" @ 3440
6/3394-98 1000 A S/8 BO 1 hr.
S/30 BO 5 hr.
Comp. 120 BOPD

COMPLETED