

J. G. McGEHEE

J. G. McGEHEE

Saline
Sec. 30 Twp. 15 R. 3W
Well No. #6 Larson Farm
Republic Natural Gas Company
Carey Drlg. Contr. Contractor


450 Ft. from N. Line

_____ Ft. from S. Line

1320 Ft. from E. Line

_____ Ft. from W. Line

C N/2 N/2 NW

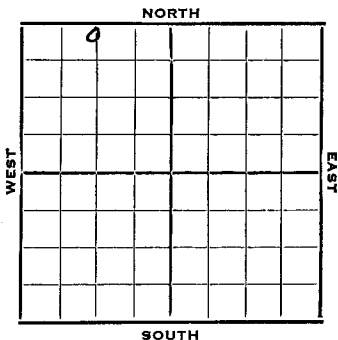

1953 Elev. 1287 REPORT

1/7 Spudding Date 12/29/52
8" @ 310 Anhy 345
Drlg. 2345
1/22 Mq Dol 3392' TD 3443' 5" @ 3443
CO 30/3395-3400
1/29 P/6 BOPH
2/5 1000 A S/3 BOPH & 5% wtr
S/88 BO & 36 BWPD
2/11 Spud 12-29-52
Oil Well
TD 3443'
8" @ 310
Anhy 345, Hunton 3301, Maq.
3392
TD 3443
5" @ 3443
30/3395-3400, 1000A, S/3 boph
5% wtr.
S/88 bo 36 bwph
S/30 bo 6 bw 7 hrs.
P/62 bo 10 bw 20 hrs.
Comp. 100 bopd 19% wtr.

COMPLETED

FORM 51 Saline KANSAS
Section 30 Township 15 Range 3W
Well No. 6 Larson
Company Republic Natural Gas

