

County **Saline** State **Kansas**

Sec. **30** (Bk. Twp.) **15** (Sur. Rge.) **3W** Map No.

Operator **Johnson Bros. & Carey Drlg.**

Well No. **2** Farm **Larsen**

Elev. Location **NW NW NW**

0									

FIRST REPORT

330 Ft. From **N** Line **NW**

330 Ft. From **W** Line **Quarter**

1st. Report **DEC 6 1950**

Completion

Remarks **Carey Drlg. - Contr.**

Spudding Date

Drlg. Data **Smoland Pool**

Location

J. E. TYRA

County **Saline** State **Kansas**

Sec. **30** (Bk. Twp.) **15** (Sur. Rge.) **3W** Map No.

Operator **Johnson Bros. & Carey Drlg.**

Well No. **2** Farm **Larsen**

Elev. **1289** Location **NW NW NW**

0									

COMPLETE

330 Ft. From **N** Line **NW**

330 Ft. From **W** Line **Quarter**

1st. Report

Completion **JAN 17 1951**

Remarks **Smolan Pool**

Carey Drlg. - Contr.

Spudding Date **12-13-50**

Drlg. Data **Oil well TD 3413**

8" @ 315 Miss. 2854 Kinderhook 3168

Misenor 3309 Hunton 3311 Maq. 3341

Maq. dol. 3405 DST 3406-09 open 15 min.

Rec. 20' ocm 200' oil 5" @ 3405

TD 3413 S/ 5 boph Comp. 313 bopd

J. E. TYRA

Saline

KANSAS

Sec. 30 Twp. 15 R. 3W

Well No. #2 Larsen Farm

Johnson Bros. & Carey Drlg. Company

Carey Drlg. - Contr. Contractor

Smoland Pool


330' Ft. from N. Line

_____ Ft. from S. Line

_____ Ft. from E. Line

330' Ft. from W. Line

NW NW NW

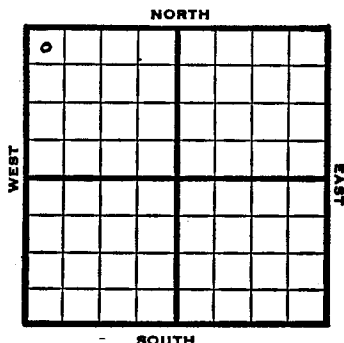


Saline

KANSAS

Section 30 Township 15 Range 2W

Well No. #2 Larsen

Company Johnson Bros. & Carey Drlg.

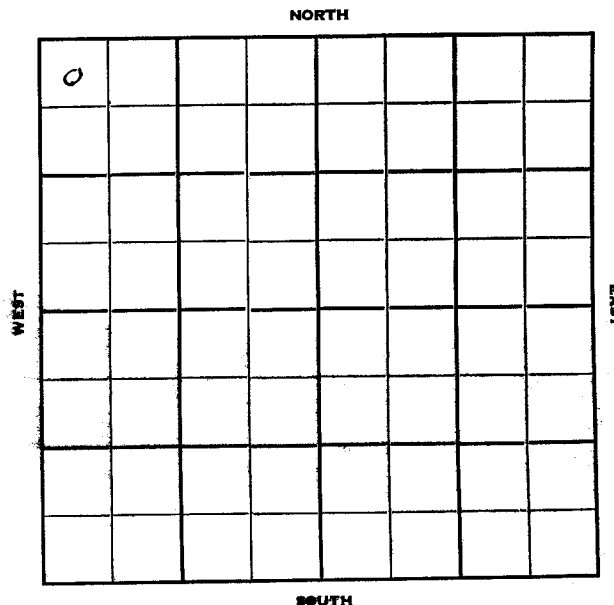

1950 Elev. 1289' REPORT

12/6 Location

1951

1/17

Spud 12-13-50
Oil Well TD 3413
8" @ 315' Miss 2854
Kinderhook 3168' Misenor 3309'
Hunton 3311' Maq. 3341
Maq. dol. 3405'
DST 3406-09 opn 15 min
Rec. 20' ocm 200' oil
5" @ 3405 TD 3413 S/5 boph
Comp. 313 bopd

COMPLETED