


County Saline State Kansas
 Sec. 30 (Bk. Twp.) 15 (Sur. Rge.) 3W Map No.
 Operator Republic Natural
 Well No. 7 Farm Larson "B"
 Elev. 1289 Location C S L SWNW

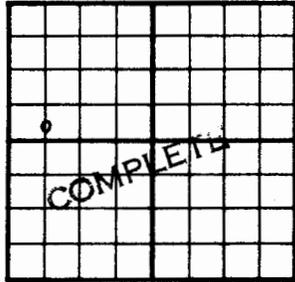

330 Ft. From S Line NW
660 Ft. From W Line Quarter
 1st. Report
 Completion APR 15 1953
 Remarks Smolan Pool
E.K. Carey - Contr.
 Spudding Date 2-12-53

Drlg. Data Oil well TD 3450
15" @ 91 10" @ 361 TD 3450 7" @ 3450
Maq. 3402 24/ 3402-06 S/ 7 1/2 boph 6 hr.
Miss. 2864 Kh. 3164 Misener 3305
Hunton 3311 Viola 3402 S/ 5 boph 6 hr.
Comp. 116 bopd 1% wtr.


J. G. McGENEE

Sec. #7 Twp. Larson "B" R.

Well No. Republic Natural Farm Company

E. K. Carey Contractor
Smolan Pool

~~990~~ Ft. from N. Line
330 Ft. from S. Line
 Ft. from E. Line
~~990~~ Ft. from W. Line

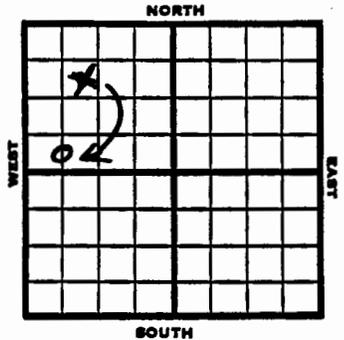

C S L SW NW
~~SE NW NW~~

1953 Elev. 1289' **REPORT**

1/28 Location
 2/5 "
 2/12 "
 2/29 15" @ 91 10" @ 361
 Drlg. 770'
 2/26 Drlg. 3117'
 3/12 Mq Dol 3402' RTD 3450' 7" @ 3450
 24/3402-06 S/7 1/2 BOPH 6 hrs.
 3/19 S/5 BOPH 6 hrs.
 3/26 NR
 4/2 "
 4/9 "
 4/15 Spud 2-12-53
 Oil Well
 TD 3450
 15" @ 91
 10" @ 361
 TD 3450
 7" @ 3450
 Maq. 3402
 24/3402-06, S/7 1/2 boph 6 hrs.
 Miss 2864, Kh. 3164, Misener 3305,
 Hunton 3311, Viola 3402,
 S/5 boph 6 hrs.
 Comp. 116 bopd 1% wtr.

COMPLETED

FORM 51 Saline

KANSAS

Section 30 Township 15 Range 3W

Well No. #7 Larson

Company Republic Natural

