

Sec. 30 Twp. 15

R. 3 W ✓

Well No. # 4 Larson Farm

E. K. Cary Company

E. K. Carey Contractor
Smolan


Ft. from N. Line

990 Ft. from S. Line

Ft. from E. Line

330 Ft. from W. Line

NW SW NW

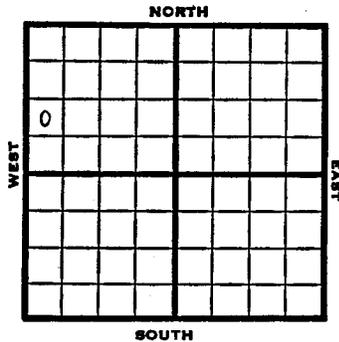

1951

Elev. 1288' REPORT

10/10 Location

12/12 Spud 10-21-51

Oil Well TD 3404

8-5/8" @ 319

Miss 2858

Kh 3174 Hunton 3306

Maq dol. 3398

TD 3399

5" @ 3398 DD 3404

S/5 Boph 2 hr.

Comp. 490 bopd

COMPLETED

Section 30 Township 15 Range 3 W

Well No. # 4 Larson

Company E. K. Carey

