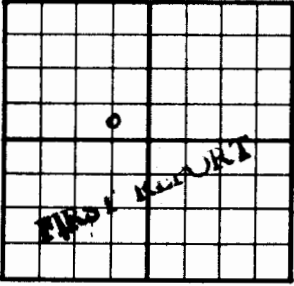
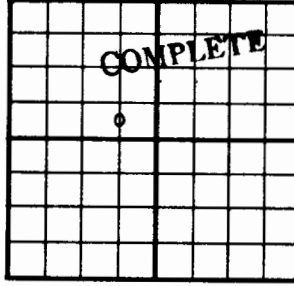


County Saline State Kansas
 Sec. 30 (Blk. 15 (Sur. 3W Map No.
 Operator E. K. Carey
 Well No. 3 Farm Larson
 Elev. _____ Location CS/2 SE NW

330 Ft. From S Line NW
660 Ft. From E Line Quarter
 Ist. Report JUL 11 1951
 Completion _____
 Remarks E. K. Carey - Contr.
 Spudding Date 7-9-51
 Drlg. Data Smolan - pool

Drlg.

J. E. TYRA

County Saline State Kansas
 Sec. 30 (Blk. 15 (Sur. 3W Map No.
 Operator E. K. Carey
 Well No. 3 Farm Larson
 Elev. 1288 Location C S L SE NW

330 Ft. From S Line NW
660 Ft. From E Line Quarter
 Ist. Report _____
 Completion AUG 15 1951
 Remarks Smolan Pool
Carey - Contr.
 Spudding Date 7-9-51
 Drlg. Data Oil well TD 3400

8" @ 311 Miss. 2856 Kh. 3169

Misenor 3303 Hunton 3305 Maq. sh. 3335

Maq. dol. 3395-98 TD 5" @ 3395

FU 1570' oil 14 hr. 2150' oil 18 hr.

DD 3399 FU 1935' oil 17 hr. DD 3400

S/ 5 boph 1000 A S/ 16 boph

Comp. 616 bopd

J. E. TYRA

Saline

KANSAS

Sec. 30 Twp. 15 R. 3 W

Well No. # 3 Larson Farm

E. K. Carey Company

E. K. Carey Contractor

Smolan Pool


Ft. from N. Line

330 Ft. from S. Line

660 Ft. from E. Line

Ft. from W. Line

C S/2 SE NW

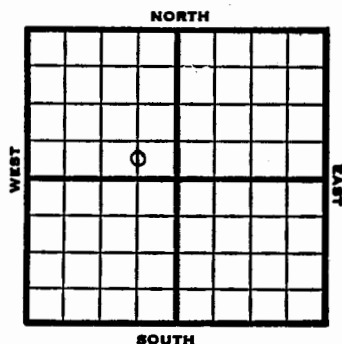

1951 Elev. 1288' REPORT

7/11 Spud 7-9-51
Drilling

8/15 Spud 7-9-51
Oil well TD 3400' 8" @ 311
Miss 2856' Kh. 3169' Misenor 3303'
Hunton 3305' Maq. sh. 3335'
Maq. dol. 3395-98' TD 5" @ 3395'
FU 1570' oil 14 hr. 2150' oil 18 hr.
DD 3399' FU 1935' oil 17 hr.
DD 3400' S/5 BOPH 1000 A
S/16 BOPH
Comp. 616 BOPD

COMPLETED

KANSAS

Section 30 Township 15 Range 3 W

Well No. # 3 Larson

Company E. K. Carey

