

County Saline State Kansas
 Sec. 30 (Bik.) 15 (Sur.) 30 Map No. _____
 Operator Geo Serel
 Well No. 2 Farm Serel - Larson
 Elev. 1287 Location SW SW NE

						<u>330</u>	Ft. From	<u>8</u>	Line	<u>NE</u>
						<u>330</u>	Ft. From	<u>W</u>	Line	Quarter
						1st. Report <u>OCT 17 1951</u>				
						Completion _____				
						Remarks _____				
						Spudding Date _____				

Drig. Data Smolan
 Location

J. E. TYLER

County Saline State Kar
 Sec. 30 (Bk. Twp.) 15 (Sur. Rge.) 3W Map No. _____
 Operator Geo. Sercl
 Well No. 2 Farm Sercl - Larson
 Elev. 1287 Location SW SW NE

330 Ft. From S Line NE
 330 Ft. From W Line Quarter
 1st. Report _____
 Completion DEC 5 1951
 Remarks Smolan pool
 Spudding Date 10-22-51
 Drlg. Data Oil well TD 3407

J. E. TYRA

Saline

KANSAS

Sec. 30 Twp. 15 R. 3W

Well No. #2 Sercl - Larson Farm

Geo Sercl Company

Contractor

Smolan


Ft. from N. Line

330' Ft. from S. Line

Ft. from E. Line

330' Ft. from W. Line

SW SW NE

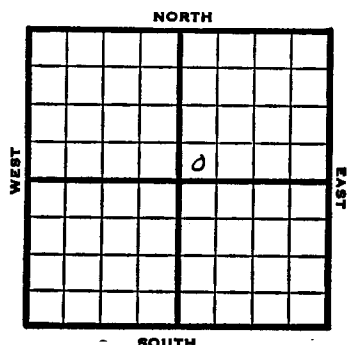

1951 Elev. 1287' REPORT

10/17 Location

12/5 Spud 10-22-51

Oil well TD 3407

8" @ 305

Miss. 2862 Kh. 3176

Misn. 3307 Hunton 3310

Mag. dol. 3376 Maq. sh. 3395

Viola 3404-05

5" @ 3404' TD 3407

1000 A FU 740' oil 15 hr.

S/ 2 BOPH 3 hr.

Comp. 77 BOPD 25% wtr.

COMPLETED

Saline

KANSAS

Section 30 Township 15 Range 3 W

Well No. # 2 Sercl-Larson

Company Geo Sercl

