


County Saline State Kansas
 Sec. 30 (Bk. 15) (Sur. 3W) Map No.
 Operator Carrier - Keyes
 Well No. 2 Farm Swenson
 Elev. 1286 Location NW NW SE

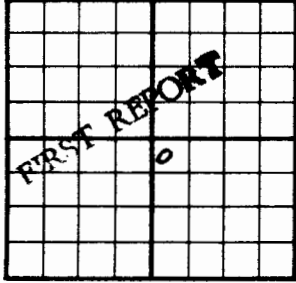


330 Ft. From N Line SE
330 Ft. From W Line Quarter
 Ist. Report DEC 1 2 1951
 Completion
 Remarks
 Spudding Date

Drlg. Data

Smolan PoolCellar & pitsJ. E. TYRA

County Saline State Kansas
 Sec. 30 (Bk. 15) (Sur. 3W) Map No.
 Operator Carrier - Keyes
 Well No. 2 Farm Swenson
 Elev. 1286 Location NW NW SE

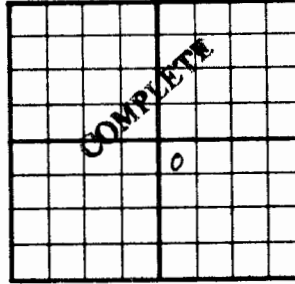

330 Ft. From N Line SE
330 Ft. From W Line Quarter
 Ist. Report
 Completion APR 9 1952
 Remarks Smolan Pool
Sterling Drlg. - Contr.
 Spudding Date 12-24-51

Drlg. Data Oil well TD 34038" @ 333 Miss. 2846 Th. 3170Misener 3305 Hunton 3307 Mag. 3333Dol. 3401 TD 3402 5" @ 3401DD 3403 1500 A P/ 20 bopd Hydro.Comp. 35 bopdJ. G. McGEHEE

Saline **KANSAS** 3W

Sec. 30 Twp. 15 R. 3W

Well No. #2 Swenson Farm

Currier- Keyes Company

Contractor

Smolan Pool


330' Ft. from N. Line

Ft. from S. Line

Ft. from E. Line

330' Ft. from W. Line

NW NW SE

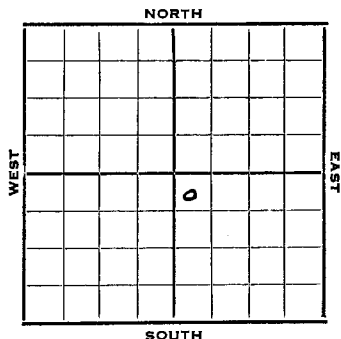

1951 Elev. 1286' REPORT

12/12 Cellar & Pits

1952

2/6 TD 3402 5" @ 3401
P 20 BOPD

2/13 No report

2/20 "

3/5 P/15 BOPD

3/11 NR

3/19 Hyd

3/25 P/ 30 BOPD

4/1 NR

4/9 Spud 12-24-51

Oil Well TD 3403

8" @ 333 Miss. 2846 Kh. 3170

Mis. 3305 Hunton 3307

Maq. 3333 Dolo 3401

TD 3042 5" @ 3401

DD 3403 1500 A P. 20 bopd

Hydro. Comp. 35 bopd

COMPLETED

KANSAS

Section 30 Township 15 Range 3W

Well No. #2 Swenson

Company Currier-Keyes

