



Saline KANSAS

Sec. 30 Twp. 15 R. 3 W

Well No. # 1 Larson "A" Farm

E. K. Carey & Johnson Company

Carey Drlg. Contractor


330 Ft. from N. Line

Ft. from S. Line

660 Ft. from E. Line

Ft. from W. Line


C N L NE SW

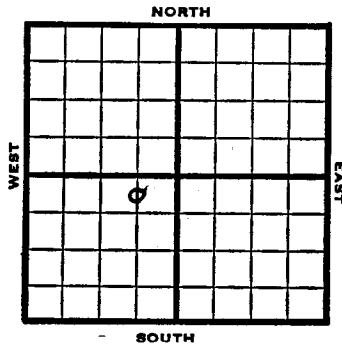

Section 30 Township 15 Range 3 W

Well No. # 1 Larson "A"

Company E. K. Carey & Johnson

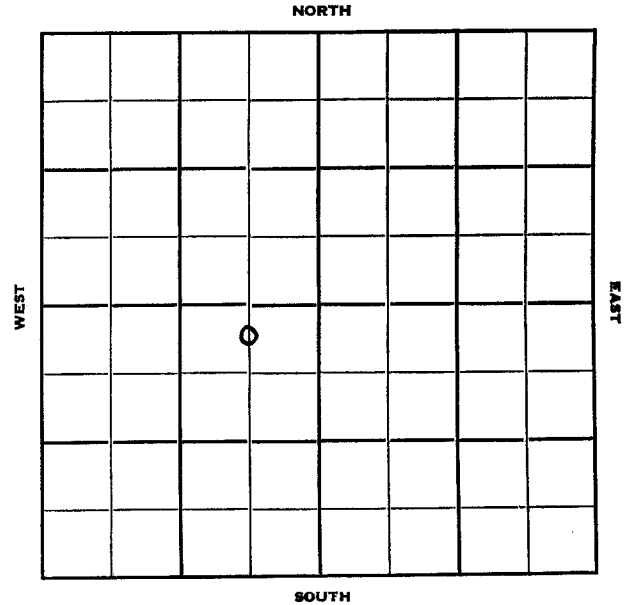

1951 Elev. 1287' REPORT

2/28 Spud 2-24-51  
8" @ 318'  
Drlg. 350'

3/28 Spud 2-24-51  
Oil well TD 3402'  
8" @ 318 Miss. 2850' Kinderhook  
3158', Misenor 3244', Hunton  
3307', Maq. 3335'  
TD 3402' 5" @ 3398 FU 2250' oil  
Comp. 465 BOPD

COMPLETED