

County **Saline** State **Kansas**
 Sec. **30** (Bk. **15** (Sur. **3W** Map No.
 Operator **F. A. Ostenberg**
 Well No. **1** Farm **F. W. Ostenberg**
 Elev. Location **SE NE SW**
 990 Ft. From **N** Line **SW**
 330 Ft. From **E** Line Quarter
 1st. Report **FEB 7 1951**
 Completion
 Remarks **Melland - Contr.**
 Spudding Date
 Drlg. Data **Smolan Pool**
R U R

J. E. TYRA

County **Saline** State **Kansas**
 Sec. **30** (Bk. **15** (Sur. **3W** Map No.
 Operator **F. A. Ostenberg**
 Well No. **1** Farm **F. W. Ostenberg**
 Elev. **1291** Location **SE NE SW**
 990 Ft. From **N** Line **SW**
 330 Ft. From **E** Line Quarter
 1st. Report
 Completion **APR 4 1951**
 Remarks **Smolan Pool**
 Melland - Contr.
 Spudding Date **2-8-51**
 Drlg. Data **Oil well TD 3410**

8" @ 330 Miss. 2862 Kinderhook 3160
 Misenor 3316 Hunton 3320 Maq. 3342
 Dol. 3406-10 DST 3407-10 open 45 min.
 Rec. 130' oil 10' hocm 5½" @ 3407
 TD 3410 FU 800' oil 45 min. 2500' oil
 7 hr. P/ 6 boph 1000 A P/ 16 boph
 Comp. 571 bopd

J. E. TYRA

Saline KANSAS

Sec. 30 Twp. 15 R. 3 W

Well No. #1 F. W. Ostenberg Farm

F. A. Ostenberg Company

Melland Contractor


Smolan Pool

990 Ft. from N. Line

Ft. from S. Line

330 Ft. from E. Line

Ft. from W. Line

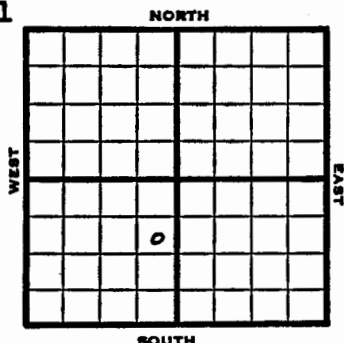

SE NE SW

1951 Elev. 1291' REPORT

2/7 RUR

4/4 Spud 2-8-51 Oil well TD 3410'
8" @ 330' Miss 2862' Kinderhook
3160', Misenor 3316', Hunton 3320',
Maq. 3342' Dol 3406-10
DST 3407-10 open 45 min. Rec. 130' oil
10' HOCM, 5 1/2" @ 3407' TD 3410'
FU 800' oil 45 min. 2500' oil 7 hr.
P/ 6 BOPH 1000 A P/ 16 BOPH
Comp. 571 BOPD

COMPLETED

Saline

KANSAS

Section 30 Township 15 Range 3W

Well No. #1 F. W. Ostenberg

Company F. A. Ostenberg

