

County Saline State Kansas

Sec. 30 (Blk. Twp.) 15 (Sur. Rge.) 3 W Map No.

Operator Ostenberg Bros. & R.E. Brown

Well No. 4 Farm Ostenberg

Elev. Location SW NW SW

990 Ft. From N Line SW
330 Ft. From S Line Quarter

lst. Report OCT 22 1967

Completion

Remarks Shields - Contr.
Spudding Date 10-16-82

Drlg. Data Smolan Pool

8" @ 337 drlg. 1480

J. G. McGEHEE

County	Saline		State	Kansas	
Sec.	30	(Blk.) (Twp.) 15	(Sur.) (Rge.) 3W	Map No.	
Operator	Ostenberg Bros. & R. E. Brown				
Well No.	4	Farm	Ostenberg		
Elev.	1293	Location	SW NW SW		
			990 Ft. From N Line SW		
			330 Ft. From W Line Quarter		
			1st. Report		
			Completion DEC 17 1952		
			Remarks Smolan Pool		
			Shields - Contr.		
			Spudding Date 10-16-52		
			Drig. Data Oil well TD 3404		
			8" @ 337 Miss. 2876 Mag. 3401 TD 3402		
			5" @ 3401 Kh. 3164 Hunton 3316		
Mag. 3337 DD 3404 FU 850' oil 10 hr.					
S/ 5 boph P/ 4 boph Comp. 225 bopd					

J. G. McGEHEE

Saline KANSAS
Sec. 30 Twp. 15 R. 3W

Well No. #4 Ostenberg Farm

Ostenberg Bros. & R. E. Brown Company

Shields Contractor

Smolan Pool


990 Ft. from N. Line

Ft. from S. Line

Ft. from E. Line

330 Ft. from W. Line

SW $\frac{1}{4}$ SW NW SW

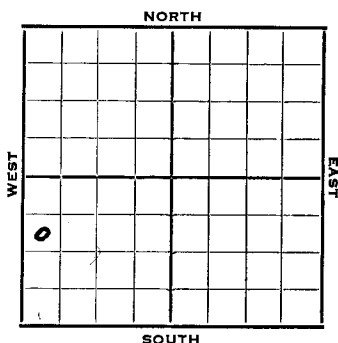

1952 Elev. 1293' REPORT

10/22 Spud 10-16-52
8" @ 337'

Drlg. 1480'

10/29 Miss li 2876'

Drlg. 3130'

11/5 Mq Dol. 3401

RTD 3402

5" @ 3401'

11/12 KH 3164 Htn. 3316

Mq. Shale 3337

DD 3404' 850' oil 10 hrs.

S/5 Boph 6 hrs. 300' off btm.

11/20 P/4 BO 1 hr.

11/27 NR

12/4 "

12/11 NR

12/17 Spud 10-16-52

Oil Well

TD 3404'

8" @ 337'

Miss 2876, Maq 3401

TD 3402

5" @ 3401

Kh. 3164, Hunton 3316, Maq.

3337

DD 3404

FU 850' oil 10 hrs.

S/5 boph P/4 boph

Comp. 225 bopd

COMPLETED

Section 30 Township 15 Range 3W

Well No. #4 Ostenberg

Company Ostenberb Bros. & R.E. Brown

