

County	Saline		State	Kansas
Sec.	30 (Blk. Twp.)	15 (Sur. Rge.)	SW	Map No.
Operator	F. A. Osenberg			
Well No.	2	Farm	Osenberg	
Elev.	Location		SE SW SW	

	380	Ft. From	8	Line	SW
	990	Ft. From	W	Line	Quarter
	1st. Report				
	Completion				
	Remarks				
Spudding Date					

Drlg. Data

Location Smolan Pool

J. E. TYRA

County	Saline	State	Kansas
Sec.	30 (Bk. Twp.)	15 (Sur. Rge.)	3W Map No.
Operator	F. A. Osenberg		
Well No.	2	Farm	Osenberg
Elev.	1299	Location	SE SW SW

	330 Ft. From	S Line	SW
	990 Ft. From	W Line	Quarter
	1st. Report		
	Completion	AUG 29 1951	
0	Remarks		Smolan Pool
	Northwestern Drlg. - Cont		
	Spudding Date		7-7-51

Drig. Data Oil well TD 3415

8" @ 346 Miss. 2881 Kh. 3173

Nisener 3322 Hunton 3325 Maq. 3344

Dol. 3414 TD 3415 $4\frac{1}{8}"$ @ 3413 S/ 8 boph

Comp. 693 bopd

J. E. TYRA

Saline

KANSAS

Sec. 30 Twp. 15 R. 3 W ✓

Well No. # 2 Osenberg Farm

F. A. Osenberg Company

Contractor

Smolan Pool


Ft. from N. Line

330 Ft. from S. Line

Ft. from E. Line

990 Ft. from W. Line

SE SW SW

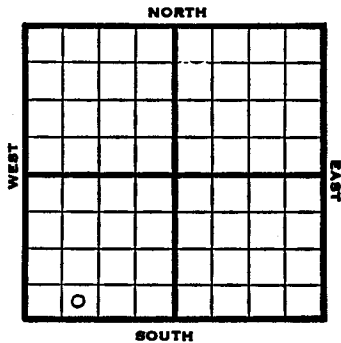

1951

Elev. 1299' REPORT

6/13 Location

8/29 Spud 7-7-51

Oil Well TD 3415

8" @ 346 Miss 2881

Kh 3173 Misener 3322

Hunton 3325 Maq. 3344

Dol. 3414 TD 3415

4½" @ 3413 S/8-1-51 Comp. 693 bopd

COMPLETED

Saline

KANSAS

Section 30 Township 15 Range 3W

Well No. #2 Osenberg

Company F. A. Osenberg

