

Saline

KANSAS ✓

Sec. 30 Twp. 15 R. 3W

Well No. #3 Osterberg Farm

Osterberg & Bauman Company

Shields - Contr. Contractor


Ft. from N. Line

330' Ft. from S. Line

Ft. from E. Line

330' Ft. from W. Line


SW SW SW

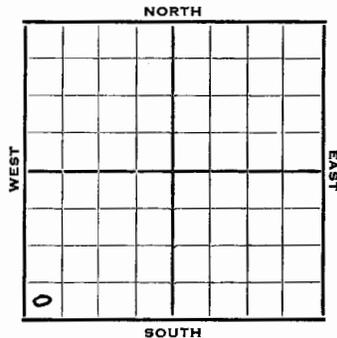

Section 30 Township 15 Range 3 W

Well No. # 3 Osterberg

Company Osterberg & Bauman

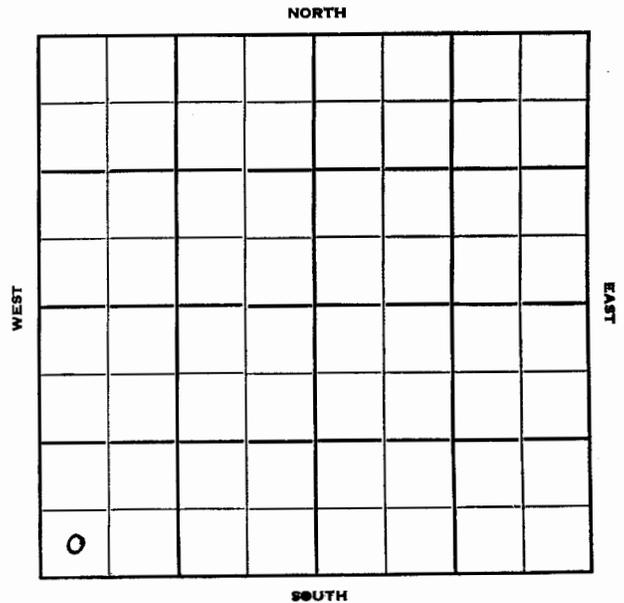

1952 Elev. 1300' REPORT

2/20 Cellar & Pits

3/5 Drlg. 3130'

3/11 Miss 2879 KH 3184 Misner 3325
Htn 3328 Mq. shale 3346 Mq Dol 3412
TD 3413 5" @ 3412 WOCT

3/19 "

3/25 DP DD to 3414 S/ 4 boph
for 9 hrs. POP

4/1 POP

4/9 "

4/23 NR

4/30 "

5/7 "

5/14 "

5/21 NR

5/28 "

6/11 Spud 2-22-52
Oil well TD 3414' 8" @ 322
Miss 2879' Kh. 3184' Misener 3325'
Hunton 3328' Maq. 3346' Maq. dol.
3412' TD 3413' 5" @ 3412 DD 3414
S/4 BOPH P/11 BOPH
Comp. 225 BOPD

COMPLETED