


County Saline State Kansas
 Sec. 31 (Blk. 15 (Sur. SW Map No.
 (Twp.) (Rge.)
 Operator Shields Oil Prod.
 Well No. 1 Farm Liljinstrand
 Elev. Location NW NW NE

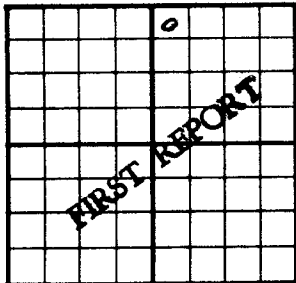


330 Ft. From N Line NE
330 Ft. From N Line Quarter
 Ist. Report JAN 23 1952
 Completion
 Remarks
 Spudding Date

Drlg. Data Smolan
Location

J. E. TYRA

County Saline State Kansas
 Sec. 31 (Blk. 15 (Sur. 3W Map No.
 (Twp.) (Rge.)
 Operator Shields Oil Prod.
 Well No. 1 Farm Liljinstrand
 Elev. 1290 Location NW NW NE

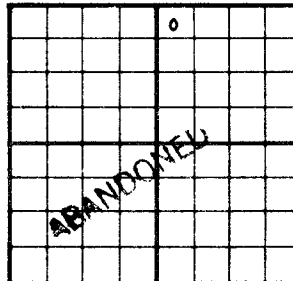

330 Ft. From N Line NE
330 Ft. From W Line Quarter
 Ist. Report
 Completion FEB 13 1952
 Remarks Smolan Pool
 Spudding Date 1-26-52

Drlg. Data D & A TD 3419
12 1/2" @ 70 8" @ 339 Miss. 2880
Kh. 3172 Hunton 3332 Mag. 3350
Dol. 3415-19 DST 3416-19 open 1 hr.
Rec. 96' sw TD 3419
D & A

J. G. McGEHEE

Saline

KANSAS

Sec. 31 Twp. 15 R. 3W

Well No. #1 Liljinstrand Farm

Shields Oil Prod. Company

Contractor

Smolan


330 Ft. from N. Line

Ft. from S. Line

Ft. from E. Line

330 Ft. from W. Line

NW NW NE

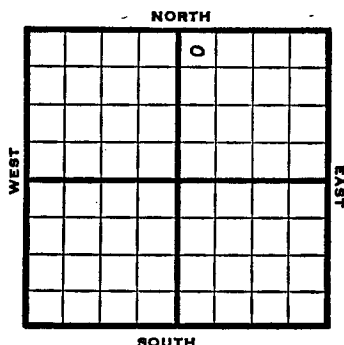

1952 Elev. 1290' REPORT

1/23 Location
2/6 Dlr. 3005'
2/13 Spud 1-26-52
D&A TD 3419
12 1/2" @ 70 8" @ 339
Miss. 2880 Kh. 3172
Hunton 3332 Maq. 3350
Dol. 3415-19
DST 3416-19 open 1 hr. rec. 96' SW
TD 3419
D&A

ABANDONED

KANSAS

Section 31 Township 15 Range 3W

Well No. #1 Liljinstrand

Company Shield Oil Prod.

