

County	Saline		State	Kansas	
Sec.	31	(Blk. Twp.) 15	(Sur. Rge.) 3W	Map No.	
Operator	Shields Oil Prod.				
Well No.	3	Farm	Bengston		
Elev.	Location NW SW NW				
		990 Ft. From	S Line	NW	
		330 Ft. From	W Line	Quarter	
		Ist. Report	MAY 23 1951		
		Completion			
		Remarks			
		Spudding Date			
Drlg. Data	Ryding Pool				
Location					

J. E. TYRA

County	Saline		State	Kansas	
Sec.	31	(Blk. Twp.) 15	(Sur. Rge.) 3W	Map No.	
Operator	Shields Oil Prod.				
Well No.	3	Farm	Bengston		
Elev.	Location NW SW NW				
		990 Ft. From	S Line	NW	
		330 Ft. From	W Line	Quarter	
		Ist. Report			
		Completion	JUL 25 1951		
		Remarks	Ryding Pool		
		Honaker Drlg. - Contr.			
		Spudding Date	6-7-51		
Drlg. Data	Oil well TD 3419				
		12" @ 61	Hunton 3329	Maq. 3350	
		Dol. 3417-19	5" @ 3417	TD 3419	
		1000 A	S/ 80 bo	4 hr.	
		Comp. 280 bopd	38% water		

J. E. TYRA

Saline

KANSAS

Sec. 31 Twp. 15 R. 3W ✓

Well No. #3 Bengston Farm

Shields Oil Prod.

Company

Honkaer Delg.

Contractor

Ryding Pool


Ft. from N. Line

990' Ft. from S. Line

Ft. from E. Line

330' Ft. from W. Line

NW SW NW

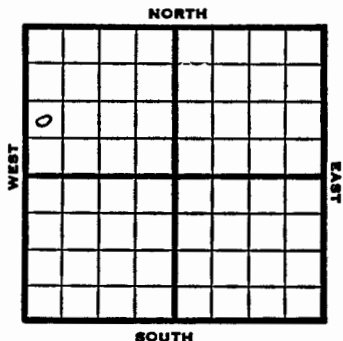


Saline

KANSAS

Section 31 Township 15 Range 3W

Well No. #3 Bengston

Company Shields Oil Prod.

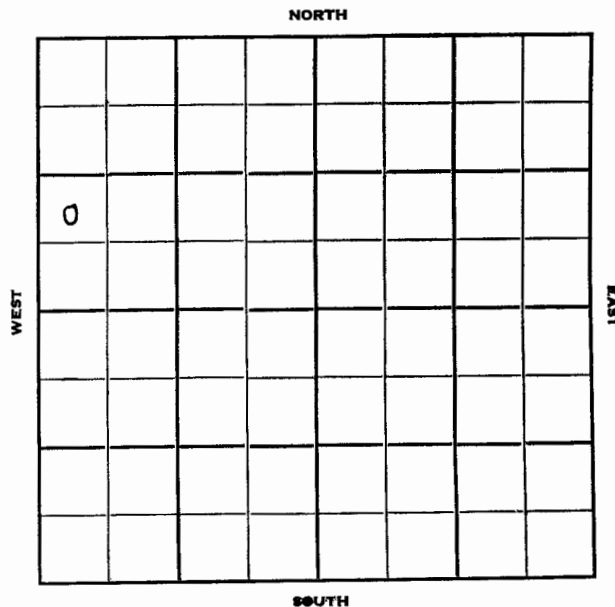

1951 Elev. 1300' REPORT

5/23 Location

7/25 Spud 6-7-51
Oil well TD 3419' 12" @ 61
Hunton 3329' Meq. 3350'
Dol. 3417-19' 5" @ 3417' TD 3419'
1000 A S/80 BO 4 hr.
Comp. 280 BOPD 38% water

COMPLETED