


County **Saline** State **Kansas**
 Sec. **31** (Blk. Twp.) **15** (Sur. Rge.) **3W** Map No.
 Operator **Shields Oil Prod.**
 Well No. **2** Farm **Bengston**
 Elev. Location **NW NW NW**

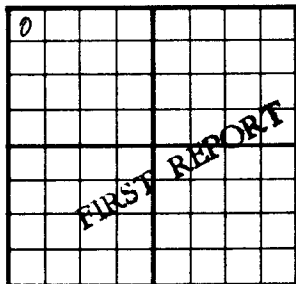


330 Ft. From **N** Line **NW**
330 Ft. From **W** Line Quarter
 1st. Report **MAY 23 1951**
 Completion
 Remarks
 Spudding Date

Drlg. Data **Ryding Pool**
 Location

J. E. TYRA

County **Saline** State **Kansas**
 Sec. **31** (Blk. Twp.) **15** (Sur. Rge.) **3W** Map No.
 Operator **Shields Oil Prod.**
 Well No. **2** Farm **Bengston**
 Elev. **1301** Location **NW NW NW**

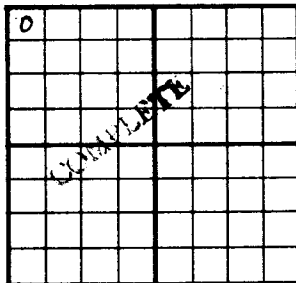

330 Ft. From **N** Line **NW**
330 Ft. From **W** Line Quarter
 1st. Report
 Completion **JUN 27 1951**
 Remarks **Ryding Pool**
Honaker Drlg. - Contr.
 Spudding Date **5-25-51**

Drlg. Data **Oil well TD 3418**

13" @ 40 8" @ 330 Kh 3167

Misener 3323 Hunton 3328 Maq. 3349

Dol. 3414 TD 3415 5" @ 3414 DD 3418

Comp. 400 bopd

J. E. TYRA

Saline

KANSAS

Sec. 31 Twp. 15 R. 3W

Well No. #2 Bengston Farm

Shields Oil Prod. Company

Contractor

Ryding Pool


330' Ft. from N. Line

Ft. from S. Line

Ft. from E. Line

330' Ft. from W. Line

NW NW NW

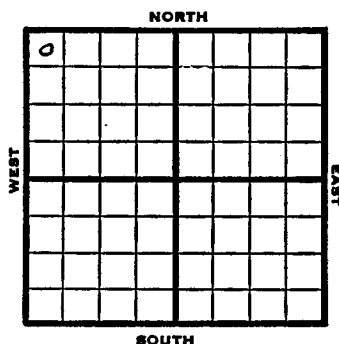

1951 Elev. 1301' REPORT

5/23 Location

6/27 Spud 5-25-51
Oil Well TD 3418
13" @ 40 8" @ 330
Kh 3167 Misenor 3323
Hunton 3328 Law. 3349
Dol. 3414 TD 3415
5" @ 3414 DD 3418
Comp. 400 bopd

COMPLETED

Saline


KANSAS

Section 31 Township 15 Range 3W

Well No. #2 Bengston

Company Shields Oil Prod.

NORTH

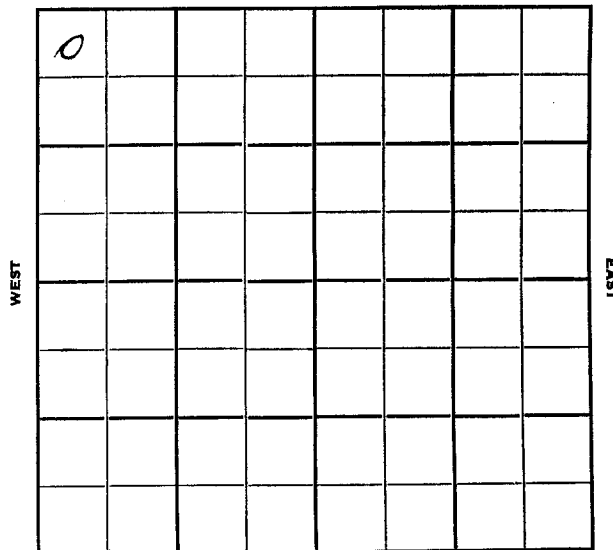

SOUTH