

County **Saline** State **Kansas**  
 Sec. **31** (Blk. **15** (Sur. **3W** (Twp. **15** (Rge. **3W** Map No.  
 Operator **R. W. Shields**  
 Well No. **1** Farm **Bengston**  
 Elev. \_\_\_\_\_ Location **NE NW NW**

0					

**330** Ft. From **N** Line **NW**  
**990** Ft. From **W** Line **Quarter**  
 1st. Report **APR 11 1951**  
 Completion \_\_\_\_\_  
 Remarks **Honaker Drlg. - Contr.**  
 Spudding Date \_\_\_\_\_

Drlg. Data **Smolan Pool**  
**Cellar & pits**

J. E. TYRA

County **Saline** State **Kansas**  
 Sec. **31** (Blk. **15** (Sur. **3W** (Twp. **15** (Rge. **3W** Map No.  
 Operator **R. W. Shields**  
 Well No. **1** Farm **Bengston**  
 Elev. **1298** Location **NE NW NW**

0					

**330** Ft. From **N** Line **NW**  
**990** Ft. From **W** Line **Quarter**  
 1st. Report \_\_\_\_\_  
 Completion **MAY 29 1951**  
 Remarks **Smolan Pool**  
**Honaker Drlg. - Contr.**  
 Spudding Date **4-14-51**

Drlg. Data **Oil well** **TD 3419**  
**8" @ 330** Miss. 2872 **Kinderhook 3169**  
**Hunton 3328** **Maq. 3349** **Dol. 3414-19**  
**5" @ 3415** **TD 3419** **S/ 28 boph**  
**Comp. 386 bopd** **3% water**

J. E. TYRA

Saline

KANSAS

Sec. 31 Twp. 15 R. 3 W ✓

Well No. # 1 Bengston Farm

R. W. Shields Company

Honaker Drlg. Contractor

Smolan Pool


330 Ft. from N. Line

\_\_\_\_\_ Ft. from S. Line

\_\_\_\_\_ Ft. from E. Line

990 Ft. from W. Line

NE NW NW

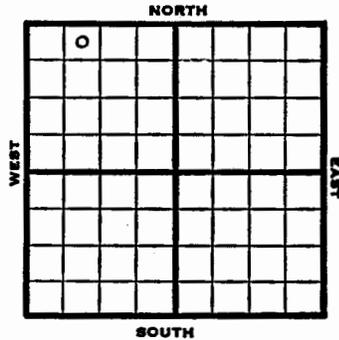


Saline

KANSAS

Section 31 Township 15 Range 3W

Well No. #1 Bengston

Company R.W. Shields

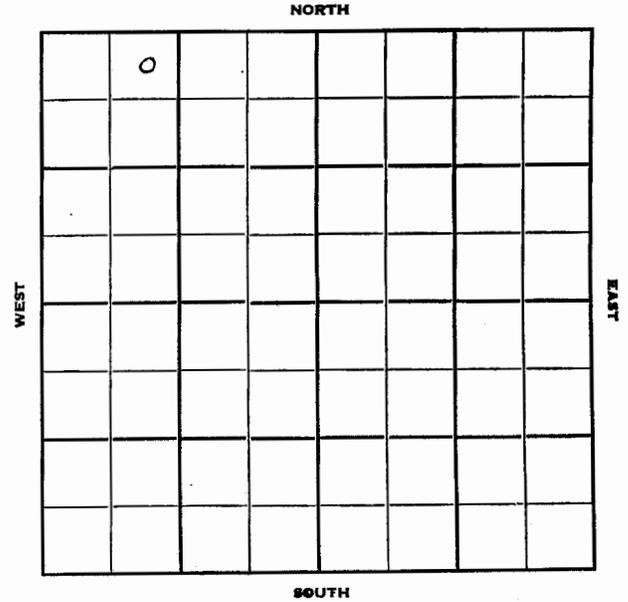

1951 Elev. 1298' REPORT

4/11 Cellar & Pits

5/29 Spud 4-14-51

Oil Well TD 3419

8" @ 330

Miss 2872 Kinderhook 3169

Hunton 3328 Maq 3349

Dol. 3414-19

5" @ 3415 TD 3419

S/28 boph Comp. 386 bopd

3% wtr.

COMPLETED