

Saline KANSAS

SEC. 32 TWP. 15 R. 3 W ✓

WELL NO. # 1 Smith FARM

COMPANY Currier & Keys

CONTRACTOR Sterling Drlg.
Salemberg Pool


330 Ft. from N. Line

Ft. from S. Line

Ft. from E. Line

990 Ft. from W. Line

NE NW NE

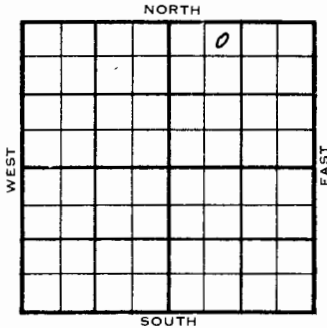

ELEVATION	REPORT
1954	1294'

1/13 Gellar & Pits
 1/20 "
 1/27 "
 2/3 8" @ 338' w/175 sks
 2/10 Drlg. 3028'
 2/17 Spud 1-30-54
 D & A
 TD 3385'
 8" @ 338' Hunton 3289'
 Maq. dol. 3366' Meisner 3288' Maq 3304
 DST 3367'-71' opn 1 hr, rec 10' Mud
 175#
 TD 3385'
 D & A

ABANDONED

FORM 51

Saline KANSAS

Section 32 Township 15 Range 3W

Well No. 1 Smith

Company Currier & Keys

