

Saline

KANSAS

SEC. 32 TWP. 15 R. 3W ✓

WELL NO. 2 Nelson FARM

COMPANY Currier & Keys

CONTRACTOR Sterling Drlg. Salemsborg Pool


330 Ft. from N. Line

Ft. from S. Line

330 Ft. from E. Line

Ft. from W. Line

NE NE SW

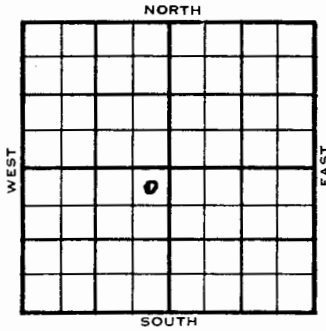


FORM 51

Saline KANSAS

Section 32 Township 15 Range 3 W

Well No. # 2 Nelson

Company Currier & Keys

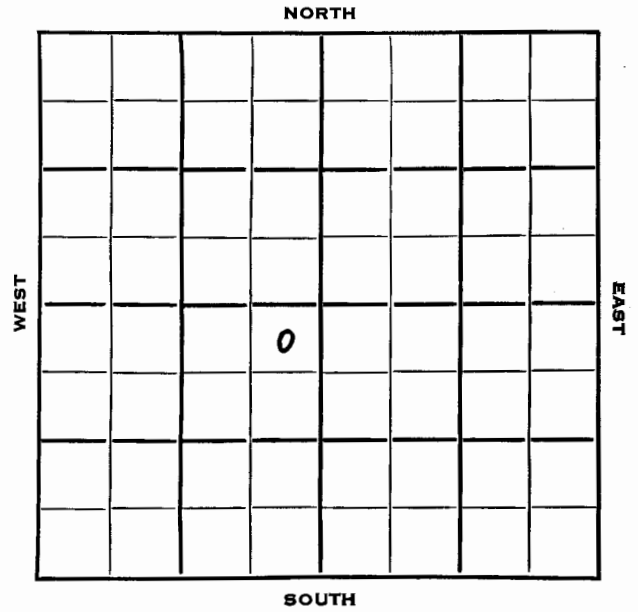

	ELEVATION	REPORT
1953	Elev. 1309'	

9/9	Spud 9-7-53 8" @ 340, WOC	
9/16	Drlg. 2640'	
9/23	Mq Dol 3397' 3401' RTD 5" @ 3397', CO	
9/30	Spud 9-7-53 Oil well TD 3401' 8" @ 340 Maq. 3397 Miss 2855 Meisner 3320 Hunton 3321 TD 3401 5" @ 3397 CO to 3401 FU 310' oil 15 hr. 20 mud-acid 500 A S/6½ BOPH 4 hr. Comp. 25 BOPD	

COMPLETED