


Saline KANSAS

Sec. 32 Twp. 15 R. 3W

Well No. #2 Martinson Farm
Sheldon & West Company
Shields Contractor

Ft. from N. Line
330 Ft. from S. Line
Ft. from E. Line
700 Ft. from W. Line

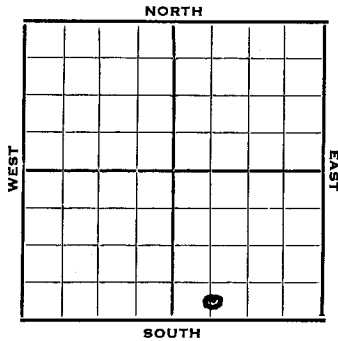

C S/2 SW SE

1953 Elev. 1300' REPORT

7/8 Don Smith - Geol.
MIRT

7/22 Burgess 2847' Miss 2850
KH 3133 Meisner 3289' Htn 3290
Maq. shale 3301' Maq. Dolo 3363'
RTD 3367'

9/16 Spud 7-7-53 Oil well TD 3367
8" @ 362 Burgess 2847 Miss 2850
Kh. 3133 Meisener 3289' Hunton 3290
Maq. sh. 3301' Maq. dol. 3363
TD 3367
DST 3364-67 open 2 hr rec 70' oil &
OCM 40# 5" @ 3364 CO to 3367
500 A S/5 BOPH Dec. to 1 BOPH
Comp. 50 BOPD

COMPLETED

Saline

KANSAS

Section 32 Township 15 Range 3W

Well No. #2 Martinson
Company Sheldon & West

