

Sec. 32 Twp. 15 R. 3 W

Well No. # 1 Martinson Farm

Sheldon & West Company

Sterling Drlg. Contractor


Ft. from N. Line

990 Ft. from S. Line

Ft. from E. Line

330 Ft. from W. Line

NW SW SE

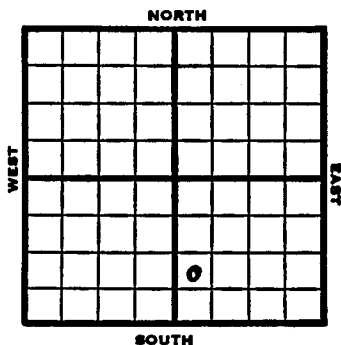


Section 32 Township 15 Range 3W

Well No. #1 Martinson

Company Sheldon & West

NORTH

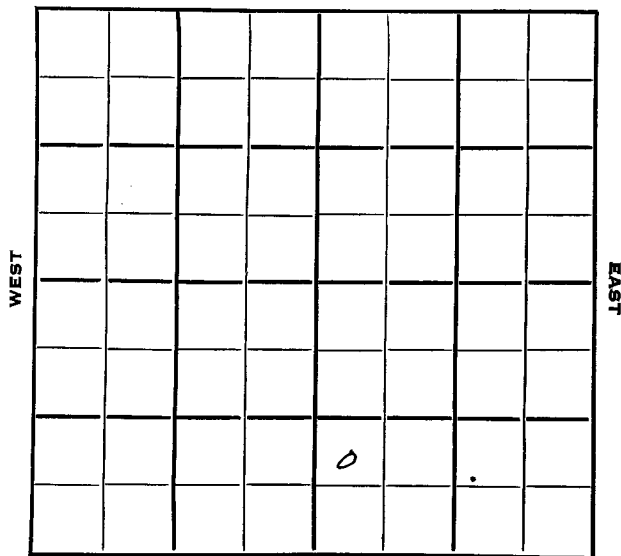

SOUTH

1953 Elev. 1300' REPORT

3/11 Spud 3-9-53
 3/19 13" @ 101 8" @ 315
 Drlg. 2420'

3/26 Miss 2850, Mq 3369
 DST 3369-74, RTD, 1 hr., 325'
 oil, 710' gas, 980#
 5" @ 3370

4/2 CO 3374 FU 1475' oil 1500 A
 S/7 BOPH 5 hrs.

4/9 NR

4/15 Spud 3-9-53
 Oil Well
 TD 3374
 13" @ 101
 8" @ 315
 Miss 2850, Maq. 3369
 DST 3369-74, opn 1 hr., rec. 325' oil
 710' gas, 980#
 5" @ 3370
 CO to 3374, FU 1475' oil, 1500A
 S/7 boph 5 hrs.
 Comp. 128 bopd 2% wtr.

COMPLETED