

Sec. 32 Twp. 15 R. 3W

Section 32 Township 15 Range 3W

Well No. #2 Johnson Farm

Well No. #2 Johnson

Sheldon & West et al Company

Company Sheldon & West et al

Shields Drlg. Contractor
Salemberg Pool



330 Ft. from N. Line

Ft. from S. Line

Ft. from E. Line

330 Ft. from W. Line

NW NW SE

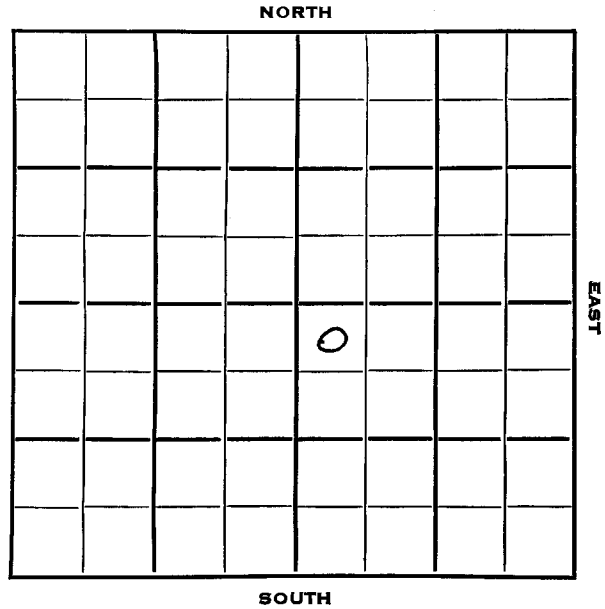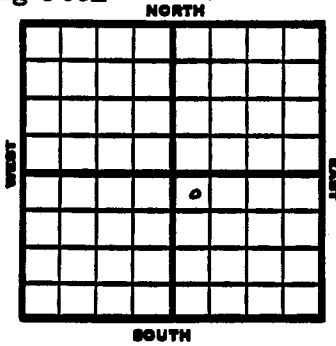

1953 Elev. 1300' REPORT

7/22 M I R

7/29 Anhy 340
8" @ 351,
Drlg. 1783'

8/5 Burgess 2854', Miss 2863', KH 3151,
Meisner 3305, Htn 3306, Mq sha 3320,
Mq dol 3379
TD 3382
5" @ 3380'

8/12 NR

9/2 Spud 7-22-53
Oil Well
TD 3382
Anhy 340,
8" @ 351
Burgess 2854, Miss 2863, Kh 3151,
Misener 3305, Hunton 3306, Maq. sh.
3320, Maq.dol. 3379
TD 3382
5" @ 3380
CO to 3382
S/7 boph 2 hrs.
Comp. 120 bopd

COMPLETED