

1953

Information brought forward

Sec. 32 Twp. 15 R. 3W

Well No. #1 Mina Johnson Farm

Sheldon & West Company

Salina Drlg. Contractor

Salemsburg Pool

5/13 1500 A S/ 7 1/2 boph
Comp. 155 bopd.

COMPLETED


990 Ft. from N. Line

Ft. from S. Line

Ft. from E. Line

330 Ft. from W. Line

SW NW SE

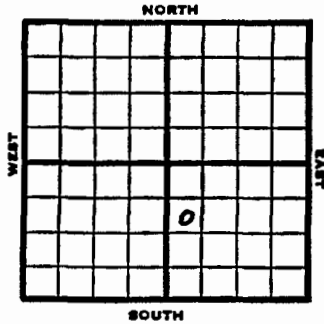

1953	Elev. 1303' REPORT
3/25	Location
4/2	8" @ 348 Drlg. 2230'
4/9	Burgess sd 2854, Miss 2860, KH 3147, Meisner sd 3302, Htn 3303, Mg sho 3316 Mg Dol 3376, DST 3377-81 RTD 1 Hr. 70' Hocm 60' oil 825# 5" @ 3377'
4/16	CO 3381, 1500A
4/23	NR
4/30	S/7 1/2 BOPH 6 hrs.
5/7	NR
5/13	Spud 3-25-53 Oil Well TD 3381' 8" @ 348' Burgess sd 2854, Miss 2860, Kh 3147, Misener 3302, Hunton 3303, Maq. sh 3316 Maq. dol. 3376, DST 3377-81 opn 1 hr, rec 70' hocm, 60' oil, 825# 5" @ 3377' CO to 3381'
	OVER

FORM 51 Saline

KANSAS

Section 32 Township 15 Range 3W

Well No. #1 Mina Johnson

Company Sheldon & West

