


KADRAI

County Saline State Kansas
 Sec. 34 (Blk.) 15 (Sur.) 3W Map No.
 Operator Phillips & Sanderson
 Well No. 1 Farm Barrett
 Elev. _____ Location NW NE NW

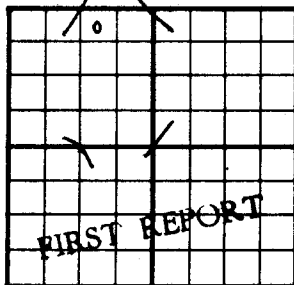

330 Ft. From N Line NW
990 Ft. From E Line Quarter
 1st. Report AUG 25 1954
 Completion _____
 Remarks J. Melland - Contr.
 Spudding Date _____

Drig. Data Swenson Pool
Cellar & pits


FABEN GILSTRAP

Map No. _____ Sec. 34 Twp. 15 R. 3W
 Well No. 1 Fleming
Phillips & Sanderson Company

CORRECTION Contractor

NW NE NW

SECTION PLAT

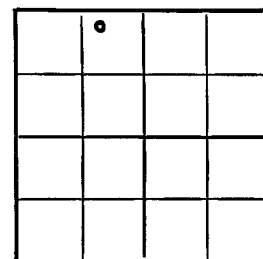

330 Ft. from N. Line
 _____ Ft. from S. Line
990 Ft. from E. Line
 _____ Ft. from W. Line

Saline County

Location _____
 Rig up _____
 Drilling and Remarks:

Reported
#1 Barrett

RECORD

Cased _____ in., _____ ft.
 Sand _____
 Gas _____
 Oil _____
 Total Depth _____

PRODUCTION

1st 24 hrs. Nat. _____
 1st 24 hrs. after shot _____
 Gas _____ Cu. Ft.
 Dry Hole _____
 Abandoned _____

Date

SEP 1 1954 19

FABEN GILSTRAP
Scout

County Saline State Kansas

Sec. 34 (Blk. 15) (Sur. 3W) Map No. 3W

Operator Phillips & Sanderson

Well No. 1 Farm Fleming

Elev. 1295 Location NW NE NW

330 Ft. From N Line NW

990 Ft. From E Line Quarter

1st. Report _____

Completion SEP 8 1954

Remarks Swenson Pool

J. Melland - Contr.


Spudding Date 8-27-54

Drig. Data D & A TD 3370

8" @ 285 Miss. 2795 Kh. 3057

Hunton 3208 Maq. sh. 3222 Maq. dol. 3293

Viola 3348 TD 3370

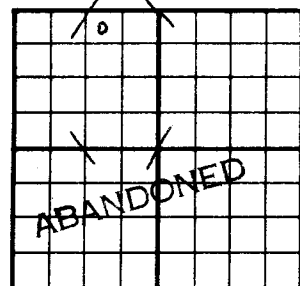

Count from

JP

FABEN GILSTRAD

O.W.W.O.

Saline KANSAS

SEC. 34 TWP. 15 R. 3W

WELL NO. 1 Fleming Barrett FARM

COMPANY Phillips & Sanderson Glickman Oil

CONTRACTOR J. Melland

Swenson Pool

330 Ft. from N. Line

990 Ft. from S. Line

990 Ft. from E. Line

990 Ft. from W. Line

NW NE NW

NORTH

WEST

EAST

SOUTH

ELEVATION	REPORT
1954	1295'
8-25	Cellar & Pits
9/8	Spud 8-27-54 D & A TD 3370
	8" @ 285 Miss 2795 Kh. 3057
	Hunton 3208 Maq. sh. 3222
	Maq. dol. 3293 Viola 3348
	TD 3370' D & A
	ABANDONED
1956	OWWO
2-22	OTD 3370
	CO to 3368
	To run 5 1/2"
	M. 2795
	K. 3057
	Hunton 3208
	Maq. Sh. 3222
	V. 3348
3-14	5 1/2" @ 3368
	CO to 3368, 25/ 3296-3300, 13/3300-02
	1000 A, frac
	S/ 2 bo 2 bwphk
	P/ 40 bo 40 bw 24 hrs.,
	Comp. 25 bopd, 25 bw
	TD 3370
	COMPLETED

O.W.W.O.

FORM 513 REV. SUNRAY

OWWO

County **Saline** Elev. **1295**
 Sec. **31** Twp. **15** Rge. **3W**
 Company **Glickman Oil (was Lee Phillips et al)**
 FarmName **Fleming** No. **1**

TOPS	DEPTH	LOG	DATUM	Loc. in Sec.
Anh.				NW NE NW
Tr.				
H.				
Tr.				
Dg.				
Bl.				
L.				
K.C.				Geol.
B.K.C.				Contr.
Ce.				Melland
C.				
M.	2795			
N.				Pool
K.	3057			Swenson
Mz.	3208			
Me.	3222			
V.	3348			
S.				
S.				
A.				
R.				
Pe.				
G.				
T.D.	3370			

FIRST REPORT
 FEB 22 '56

Date Comm.

CO to 3368 to run 5¹/₂"

FORM 513 REV. SUNRAY

OWWO

County **Saline** Elev. **1295**
 Sec. **31** Twp. **15** Rge. **3W**
 Company **Glickman Oil (was Lee Phillips et al)**
 FarmName **Fleming** No. **1**

TOPS	DEPTH	LOG	DATUM	Loc. in Sec.
Anh.				NW NE NW
Tr.				
H.				
Tr.				
Dg.				
Bl.				
L.				
K.C.				Geol.
B.K.C.				Contr.
Ce.				Melland
C.				
M.	2795		1500	
N.				Pool
K.	3057		1762	Swenson
Mz.	3208		1913	
Me.	3222		1927	
V.	3348		2055	
S.				
S.				
A.				
R.				
Pe.				
G.				
T.D.	3370			

COMPLETE

Date Comm.

MAR 14 1956

CO to 3368 5¹/₂" @ 3368 CO to 3368

25/ 3296-3300 13/ 3300-02 1000 A

frac S/ 2 bo 2 bwph P/ 40 bo

40 bw 24 hr. Comp. 25 bohd 25 bw

DX 78-1 O.W.W.O. Saline KANSAS

Section 34 Township 15 Range 3W

Well No. #1 Barrett Fleming

Company Phillips & Sanderson *Glickman Oil*

