


O.W.W.O. Saline KANSAS

County Saline State Kansas
 Sec. 34 (Blk.) 15 (Sur.) 3W Map No.
 Operator Phillips & Sanderson
 Well No. 1 Farm Fleming
 Elev. 1295 Location NW NE NW

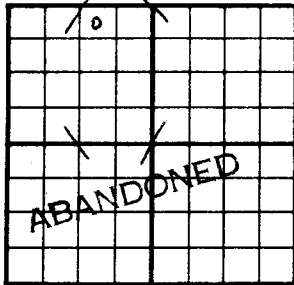

330 Ft. From N Line NW
990 Ft. From E Line Quarter
 Ist. Report _____
 Completion SEP 8 1954
 Remarks Swenson Pool
J. Melland - Contr.
 Spudding Date 8-27-54


Drig. Data D & A TD 3370
8" @ 285 Miss. 2795 Kh. 3057
Hunton 3208 Maq. sh. 3222 Maq. dol. 3293
Viola 3348 TD 3370

D & A
Count from
SP

FABEN GILSTRAD

SEC. 34 TWP. 15 R. 3W
 WELL NO. 1 *Fleming Barrett* FARM
 COMPANY Phillips & Sanderson *Glickson Oil*
 CONTRACTOR J. Melland

330 Ft. from N. Line
 _____ Ft. from S. Line
990 Ft. from E. Line
 _____ Ft. from W. Line
 NW NE NW

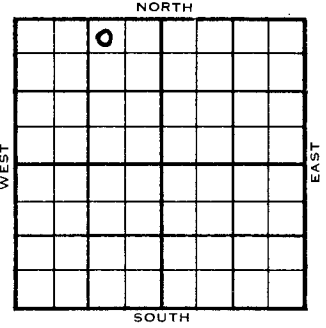

	ELEVATION	REPORT
<u>1954</u>	<u>1295'</u>	
<u>8-25</u>		<u>Cellar & Pits</u>
<u>9/8</u>		<u>Spud 8-27-54 D & A TD 3370</u> <u>8" @ 285 Miss 2795 Kh. 3057</u> <u>Hunton 3208 Maq. sh. 3222</u> <u>Maq. dol. 3293 Viola 3348</u> <u>TD 3370' D & A</u>
		ABANDONED
<u>1956</u>		<u>OWWO</u>
<u>2-22</u>		<u>OTD 3370</u> <u>CO to 3368</u> <u>To run 5 1/2"</u> <u>M. 2795</u> <u>K. 3057</u> <u>Hunton 3208</u> <u>Maq. Sh. 3222</u> <u>V. 3348</u>
<u>3-14</u>		<u>5 1/2" @ 3368</u> <u>CO to 3368, 25/ 3296-3300, 13/3300-02</u> <u>1000 A, frac</u> <u>S/ 2 bo 2 bwphk</u> <u>P/ 40 bo 40 bw 24 hrs.,</u> <u>Comp. 25 bopd, 25 bw</u> <u>TD 3370</u>
		COMPLETED

O.W.W.O

FORM 513 REV. SUNRAY

OWWO

County **Saline** Elev. **1295**
 Sec. **31** Twp. **15** Rge. **3W**
 Company **Glickman Oil (was Lee Phillips etal)**
 FarmName **Fleming** No. **1**

TOPS	DEPTH	LOG	DATUM	Loc. in Sec.
Anh.				NW NE NW
Tp.				
H.				
Tr.				
Dg.				
Bl.				
L.				Geol.
K.C.				Contr.
B.K.C.				Melland
C.				Pool
Ce.				Swenson
M.	2795			
N.				
K.	3057			
Mz.	Hampton 3208			
Mo.	Sh. 3222			
V.	3348			
S.				
A.				
R.				
Pe.				
G.				
T.D.	3370			

FIRST REPORT
 FEB 22 '56

Date Comm. **CO to 3368 to run 5 1/2"**

FORM 513 REV. SUNRAY

OWWO

County **Saline** Elev. **1295**
 Sec. **31** Twp. **15** Rge. **3W**
 Company **Glickman Oil (was Lee Phillips etal)**
 FarmName **Fleming** No. **1**

TOPS	DEPTH	LOG	DATUM	Loc. in Sec.
Anh.				NW NE NW
Tp.				
H.				
Tr.				
Dg.				
Bl.				
L.				Geol.
K.C.				Contr.
B.K.C.				Melland
C.				Pool
Ce.				Swenson
M.	2795		1500	
N.				
K.	3057		1762	
Mz.	Hampton 3208		1913	
Mo.	Sh. 3222		1927	
V.	3348		2055	
S.				
A.				
R.				
Pe.				
G.				
T.D.	3370			

COMPLETE

Date Comm. **MAR 14 1956**
CO to 3368 5 1/2" @ 3368 CO to 3368

25/ 3296-3300 13/ 3300-02 1000 A
frac S/ 2 bo 2 bwph P/ 40 bo
40 bw 24 hr. Compo. 25 bopd 25 bw

DX 78-1 O.W.W.O. Saline KANSAS

Section 34 Township 15 Range 3W

Well No. #1 Barrett Fleming

Company Phillips & Sanderson *Glickman Oil*

