

Saline KANSAS

Sec. 34 Twp. 15 R. 3W

Well No. #1 Johnson Farm

G. W. Watkin et al Company

Carey - Contr. Contractor

Swenson Pool


Ft. from N. Line

330' Ft. from S. Line

Ft. from E. Line

990' Ft. from W. Line

SE SW NW

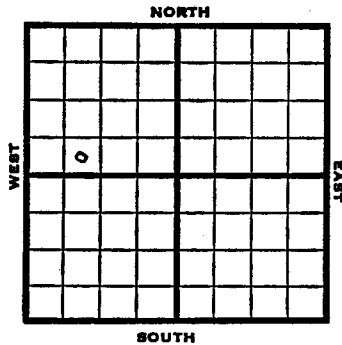


Saline KANSAS

Section 34 Township 15 Range 3W

Well No. #1 Johnson

Company G. W. Watkin et al

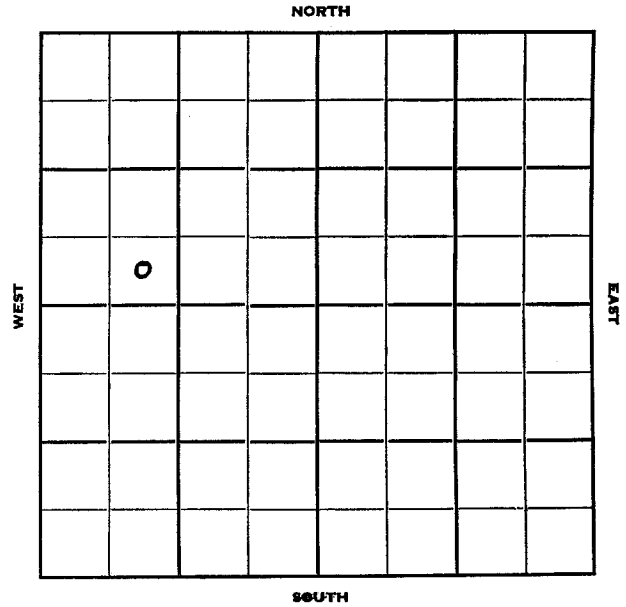

1951 Elv. 1297' REPORT

1/31 Location
 3/7 Spud 2-4-51
 Oil Well TD 3371
 8" @ 316'
 Miss 2797 Kinderhook 3052'
 Hunton 3207 Maq sh 3225'
 Maq Dol 3289' SO 3294-3303
 Villa 3346 SO 3356-68
 DST 3356-63 opn 1 3/4 hr.
 Rec. 55' ocm
 DST 3357-71 opn 2 hr Rec. 30' ocm
 60' hocm 60' socm 5" @ 3355
 TD 3371 2500 A B/2 2/3 bailers
 oil 1/4 wph Comp. 25 bo 12 bwpd

COMPLETED