

Kansas

Map No. _____ Sec. 35 Twp. 15 R. 3W

Well No. 1 Oetting

L. B. Jackson Company

Carrie Drlg. Contractor

SW SE NE

SECTION PLAT



Ft. from N. Line

330 Ft. from S. Line

990 Ft. from E. Line

Ft. from W. Line

Saline County

Location

Rig up

Drilling and Remarks:

8" @ 312

WOC

RECORD

Cased in, ft.

Sand

Gas

Oil

Total Depth

PRODUCTION

1st 24 hrs. Nat.

1st 24 hrs. after shot

Gas Cu. Ft.

Dry Hole

Abandoned

Date

APR 5 1950 19

J. E. TYRA Scout

Kansas

Map No. _____ Sec. 35 Twp. 15 R. 3W


Well No. 1 Oetting

L. B. Jackson Company

Contractor

SW SE NE

SECTION PLAT

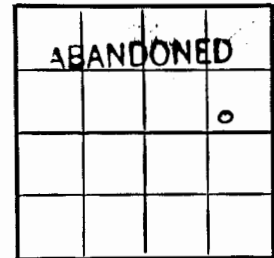

Ft. from N. Line

330 Ft. from S. Line

990 Ft. from E. Line

Ft. from W. Line

Saline County

Location

Rig up

Drilling and Remarks:

8" @ 312

5" @ 3353

K.C. 2135

Miss 2787

Luntan 3202

Viola 3335

DVA

RECORD

Cased in, ft.

Sand

Gas

Oil

Total Depth 3380

PRODUCTION

1st 24 hrs. Nat.

1st 24 hrs. after shot

Gas Cu. Ft.

Dry Hole

Abandoned

Date

MAY 3 1950

J. E. TYRA Scout

Saline KANSAS

Sec. 35 Twp. 15 R. 3W

Well No. #1 Oetting Farm

L. B. Jackson Company

Carrie Drlg. Contractor


_____ Ft. from N. Line

330' Ft. from S. Line

990' Ft. from E. Line

_____ Ft. from W. Line

SW SE NE

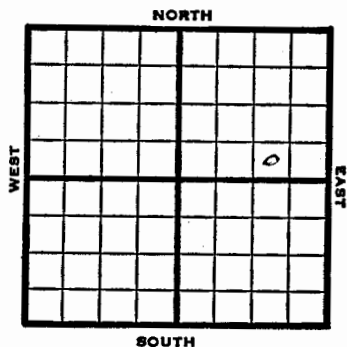

1950 Elev 1277' REPORT

4/5 8" @ 312'
WOC

5/3 TD 3380'
8" @ 312'
5" @ 3353'
KC 2135'
Miss 2787'
Hunton 3202'
Viola 3335'
D&A
Aband.

ABANDONED

KANSAS Saline

Section 35 Township 15 Range 3-W

Well No. #1 Oetting

Company L B Jackson

