

Form 26 200 Bls. 11-49 Petrol **Kansas** Olson
 Map No. _____ Sec. 35 Twp. 15 R. 3W
 Well No. 1 Bunger
 Currier & Keyes _____ Company
 _____ Contractor
 SW SW SE

SECTION PLAT

_____ Ft. from N. Line
 330 Ft. from S. Line
 _____ Ft. from E. Line
 330 Ft. from W. Line



Saline


Location _____ Rig up <u>X</u> Drilling and Remarks:	RECORD
	Cased _____ in. _____ ft. Sand _____ Gas _____ Oil _____ Total Depth _____
	PRODUCTION
	1st 24 hrs. Nat. _____ 1st 24 hrs. after shot _____ Gas _____ Cu. Ft. Dry Hole _____ Abandoned _____

Date JUN 7 1950
J. E. TYRA Scout

Form 26 200 Bls. 11-49 Petrol **Kansas** Olson Pool
 Map No. _____ Sec. 35 Twp. 15 R. 3W
 Well No. 1 Bunger
 Currier & Keyes _____ Company
 _____ Contractor
 SW SW SE

E1. 1279
SECTION PLAT

_____ Ft. from N. Line
 330 Ft. from S. Line
 _____ Ft. from E. Line
 330 Ft. from W. Line

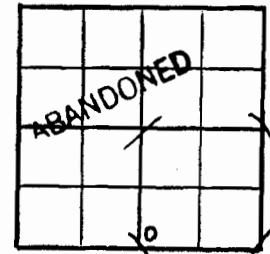

Saline County

Location _____ Rig up _____ Drilling and Remarks:	RECORD
	Cased _____ in. _____ ft. Sand _____ Gas _____ Oil _____ Total Depth 3464
	PRODUCTION
	1st 24 hrs. Nat. _____ 1st 24 hrs. after shot _____ Gas _____ Cu. Ft. Dry Hole _____ Abandoned _____

open 1 hour
 Date JUN 27 1950
J. E. TYRA Scout

Rec. 30' mud & spots of oil
 Si p. 3436-64
 D & A
 JUN 29 1950
 0561 62 NUP

Sec. 35 Twp. 15 R. 3-W

Well No. #1 Bunger Farm

Currier & Keyes Company

Olson Contractor


Ft. from N. Line

330 Ft. from S. Line

Ft. from E. Line

330 Ft. from W. Line

SW SW SE

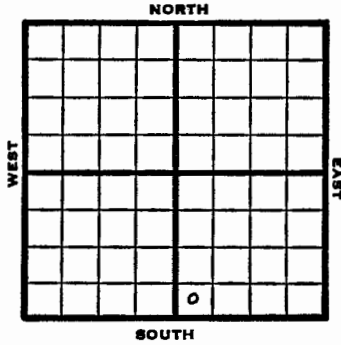

1950	Elev 1279	REPORT
6/7	Rig Up	
6/21	TD 3464 8" @ 283 Miss 2800 Maq 3292 DST 3360-90, opn 1 hr rec 30' mud & spots of oil Simp 3436-64 D&A	Kinderhook 3048 Viola 3342
ABANDONED		

Section 35 Township 15 Range 3W

Well No. #1 Bunger

Company Currier & Keys

