

KANSAS

Russell

Section - 3 Township 15 Range 12WWell No. 7 SoukupCompany Harry GoreHall-Gurney

NORTH

WEST

EAST

SOUTH

KANSAS

Russell

Sec. 3 Twp. 15 R. 12W ✓


Well No. #7 Soukup Farm

Harry Gore

Company

Hall Gurney Pool

NORTH

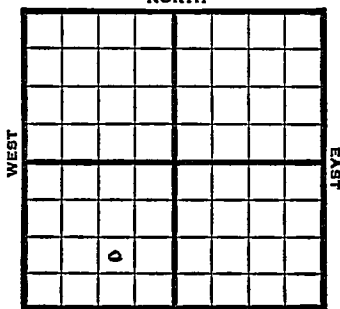

Ft. from N. Line

990'

Ft. from S. Line

990'

Ft. from E. Line

Ft. from W. Line

NW SE SW

SOUTH

1949	Elev. -	REPORT
3/16	Location	
3/23	"	
3/30	"	
4/6	"	
4/12	"	
4/20	"	
4/27	"	
5/4	"	
5/10	"	
5/18	"	
5/25	Pits	
6/1	"	
6/7	"	
6/15	"	
6/22	Abandoned Location	
	ABANDONED	

Map No. K55 Sec. 3 Twp. 15 R. 12W

Well No. 7 Soukup

Harry Gore Company

ABANDONED Contractor

NW SE SW

SECTION PLAT

 Ft. from N. Line

990 Ft. from S. Line

990 Ft. from E. Line

 Ft. from W. Line

Russell County

Location ✓

Rig up

Drilling and Remarks:

RECORD

Cased in., ft.

Sand

Gas

Oil

Total Depth

PRODUCTION

1st 24 hrs. Nat.

1st 24 hrs. after shot

Gas Cu. Ft.

Dry Hole

Abandoned

Date

JUN 22 1949

S. J. LEWIS Scout

Kansas

Map No. _____ Sec. 3 Twp. 15 R. 12WWell No. 7 SoukupHarry Gore

Company

FIRST REPORT

Contractor

NW SE SW

SECTION FLAT

	o		

_____ Ft. from N. Line

990

_____ Ft. from S. Line

990

_____ Ft. from E. Line

_____ Ft. from W. Line

Russell CountyLocation X

Rig up _____

Drilling and Remarks:

RECORD

Cased _____ in., _____ ft.

Sand _____

Gas _____

Oil _____

Total Depth _____

PRODUCTION

1st 24 hrs. Nat. _____

1st 24 hrs. after shot _____

Gas _____ Cu. Ft.

Dry Hole _____

Abandoned _____

Date

MAR 16 194919S. J. LEWIS

Scout