

COPY

SIDE ONE

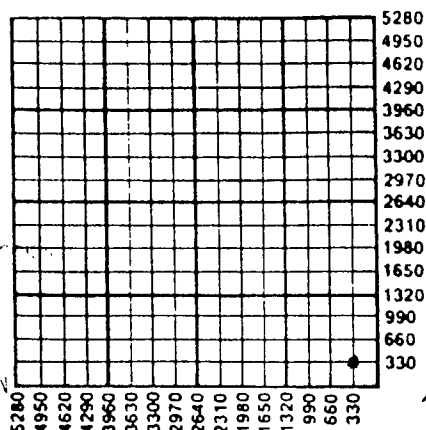
CONFIDENTIAL

STATE CORPORATION COMMISSION OF KANSAS
OIL & GAS CONSERVATION DIVISION
WELL COMPLETION FORM
ACO-1 WELL HISTORY
DESCRIPTION OF WELL AND LEASE

API NO. 15- 063-21,380

County GoveSE SE SE Sec. 22 Twp. 15S Rge. 30 ☒ East
West

330 Ft. North from Southeast Corner of Section

330 Ft. West from Southeast Corner of Section
(NOTE: Locate well in section plat below.)Lease Name Roemer Well # 1Field Name WildcatProducing Formation N/AElevation: Ground 2622' KB 2627'Total Depth 4390' PBDT

A 15 II OPA

Amount of Surface Pipe Set and Cemented at 353 FeetMultiple Stage Cementing Collar Used? ☒ Yes ☒ No

If yes, show depth set _____ Feet

If Alternate II completion, cement circulated from _____

feet depth to _____ w/ _____ sx cmt.

Operator: License # 9482Name: National Petroleum Reserves, Inc.Address 250 N. Rock Rd., #340City/State/Zip Wichita, KS 67206Purchaser: N/AOperator Contact Person: Ted BredehoftPhone (316) -681-3515Contractor: Name: Emphasis Oil OperationsLicense: 8241Wellsite Geologist: Dan DeBoer

Designate Type of Completion

☒ New Well ☐ Re-Entry ☐ Workover☐ Oil ☐ SWD ☐ Temp. Abd.☐ Gas ☐ Inj ☐ Delayed Comp.☒ Dry ☐ Other (Core, Water Supply, etc.)

If OWM: old well info as follows:

Operator: _____

Well Name: _____

Comp. Date _____ Old Total Depth _____

Drilling Method:

☒ Mud Rotary ☐ Air Rotary ☐ Cable3/11/913/19/91

Spud Date

Date Reached TD

Completion Date

INSTRUCTIONS: This form shall be completed in triplicate and filed with the Kansas Corporation Commission, 200 Colorado Derby Building, Wichita, Kansas 67202, within 120 days of the spud date of any well. Rule 82-3-130, 82-3-107 and 82-3-106 apply. Information on side two of this form will be held confidential for a period of 12 months if requested in writing and submitted with the form. See rule 82-3-107 for confidentiality in excess of 12 months. One copy of all wireline logs and drillers time log shall be attached with this form. ALL CEMENTING TICKETS MUST BE ATTACHED. Submit CP-4 form with all plugged wells. Submit CP-111 form with all temporarily abandoned wells. Any recompletion, workover or conversion of a well requires filing of ACO-2 within 120 days from commencement date of such work.

All requirements of the statutes, rules and regulations promulgated to regulate the oil and gas industry have been fully complied with and the statements herein are complete and correct to the best of my knowledge.

Signature _____

Title President/TreasurerDate 3/21/91

scribed and sworn to before me this 21 day of March,
91.

Notary Public

SUSAN BREDEHOFT
NOTARY PUBLIC
STATE OF KANSAS
My Appt. Exp. 3-1-93

Date Commission Expires 3-1-93

K.C.C. OFFICE USE ONLY

F ☒ Letter of Confidentiality Attached
C ☒ Wireline Log Received
C ☐ Drillers Timelog Received

Distribution

KCC ☒ SWD/Rep ☐ NGPA
KGS ☐ Plug ☐ Other (Specify) IS