FORM 275 FOR SALE BY KANSAS BLUE PRINT CO.


County Gove State Kansas

Sec. 10 (Blk. Twp.) 15 (Sur. Rge.) 30W Map No.

Operator Brown & Tomer

Well No. 1 Farm Fleming

Elev. Location NE NE SW

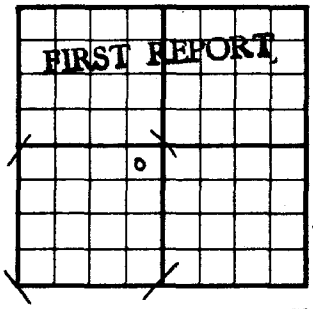

330 Ft. From N Line SW

330 Ft. From E Line Quarter

1st. Report NOV 2 8 1951

Completion

Remarks Amerada - DHM

MCPC has NW/4 & E/2 SW/4 of Sec 23

Spudding Date

Drlg. Data Wildcat

Location

J. E. TYRA

FORM 275 FOR SALE BY KANSAS BLUE PRINT CO.


County Gove State Kansas

Sec. 10 (Blk. Twp.) 15 (Sur. Rge.) 30W Map No.

Operator Brown & Tomer

Well No. 1 Farm Fleming

Elev. Location NE NE SW

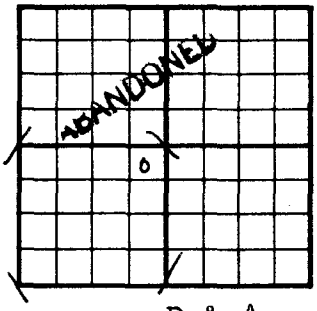

330 Ft. From N Line SW

330 Ft. From E Line Quarter

1st. Report

Completion DEC 1 9 1951

Remarks Wildcat

Spudding Date 12-1-51

Drlg. Data D & A TD 4483

10" @ 248 Heeb. 3628 Tor. 3648

KC 3667 B KC 4016 Marm. 4047

Mong. 4315 Miss. 4329 TD 4483

D & A

J. E. TYRA

FORM 252-B
10M 8-51 SFCO.

HOT FILE Gove KANSAS

Sec. 10 Twp. 15 R. 30 W ✓

Well No. # 1 Fleming Farm

Brown & Tomer Company

Contractor


Wildcat

330 Ft. from N. Line

Ft. from S. Line

330 Ft. from E. Line

Ft. from W. Line

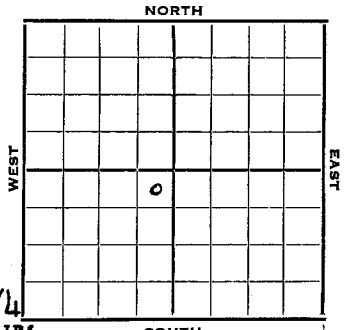

NE NE SW
MCPC has NW/4 & E/2 SW/4 of Sec. 23 Amerada DHM

1951	Elev. -	REPORT
11/28	Location	
12/7	Spudded 12-1-51 Set 10" @ 248'. WOC.	(Lt)
12/19	Spud 12-1-51 D&A TD 4483 10" @ 248 Heeb. 3628 Tor. 3648 KC 3667 B KC 4016 Marm. 4047 Cong. 4315 Miss. 4329 TD 4483 D&A	

ABANDONED

FORM 51 25M 8-50 WESTERN Gove

Section 10 Township 15 KANSAS Range 30W

Well No. #1 Fleming

Company Brown & Tomer

