

KANSAS

Gove

15-
13

30W

Sec. 12


Twp.

R.

County Gove State Kansas
 Sec. 12 (Bk. 13 (Sur. 30W Map No.

Operator Skiles
 Well No. 1 Farm Ikenberry

Elev. Location SE SE NE

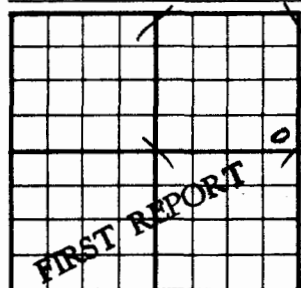

330 Ft. From 8 Line NE

330 Ft. From 8 Line Quarter

1st. Report FEB 27 1952

Completion

Remarks NCRA - DNM

Spudding Date

Drlg. Data

MI

J. G. McGEHEE

Well No. #1 Ikenberry Farm

Skiles

Company

Contractor

Ft. from N. Line

330'


Ft. from S. Line

330'

Ft. from E. Line

Ft. from W. Line

SE SE NE

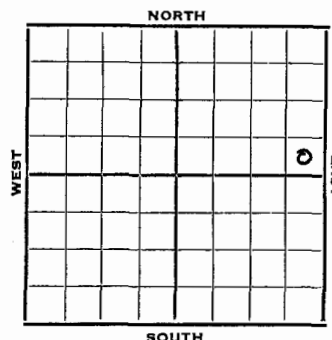

1952

Elev. 2556' REPORT

2/27

MI

3/5

10" @ 135
Drlg. 1885'

3/11

Lans. 3625
DST 3712-48, 1 hr. 525' SW
Marm 3940 Drlg. 4010'

3/19

Spud 3-1-52
D&A TD 4387
10" @ 135 Lans. 3625
DST 3712-48 open 1 hr. rec. 525' SW
Marm. 3940
DST 4090-4132 open 1 hr. rec. 60' mud
10' SOCM Miss. 4263 TD 4387
D&A

ABANDONED

County Gove State Kansas

Sec. 12 (Blk. 15) (Sur. 30W) Map No. _____

Operator Skiles Oil

Well No. 1 Farm Ikenberry

Elev. 2556 Location SE SE NE

330 Ft. From <u>S</u> Line <u>NE</u>	
330 Ft. From <u>E</u> Line <u>Quarter</u>	
1st. Report _____	
Completion <u>MAR 19 1952</u>	
Remarks _____	
Spudding Date <u>3-1-52</u>	

Drig. Data D & A TD 4387

10" @ 135 Lans. 3625 DST 3712-48

open 1 hr. Rec. 525' sw Marm. 3940

DST 4090-4132 open 1 hr. Rec. 60' mud

10' socm Miss. 4263 TD 4387

D & A


J. G. McGEHEE

Form 26 200 Bks. 11-49 Petrol Gove KansasMap No. _____ Sec. 12 Twp. 15 R. 30WWell No. 1 IkenberrySkiles Company

Contractor

SE SE NE

SECTION PLAT

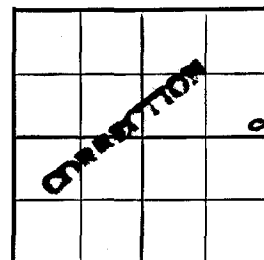

Ft. from N. Line

330 Ft. from S. Line330 Ft. from E. Line

Ft. from W. Line

N. C. R. A. -DHM

Location _____

RECORD

Cased _____ in., _____ ft.

Sand _____

Gas _____

Oil _____

Total Depth _____

Rig up _____

Drilling and Remarks:

Reported

Skiles # 1 Ikenberry **PRODUCTION**

in sec 12-13-30W

1st 24 hrs. Nat. _____

1st 24 hrs. after shot _____

Gas _____ Cu. Ft.

Dry Hole _____

Abandoned _____

Date

MAR 5 1952

19

J. G. McGEHEE

Scout

Section 12 Township ~~14~~ 15 Range 30WWell No. #1 IkenberryCompany Skiles