

County **Gove** State **Kansas**
 Sec. **9** (Blk. **15** (Sur. **31W** Map No.
 Operator **D. R. Lauck et al. (was Transwestern & Atlantic)**
 Well No. **1** Farm **Jones**

Elev. Location **NW NW NW**

0				

342 Ft. From **N** Line **NW**
330 Ft. From **W** Line Quarter
 1st. Report **APR 16 1952**
 Completion **O.W.W.O.**
 Remarks **OWO**
 Spudding Date

FIRST REPORT

Drilg. Data
Lans 3690 MissL 4330 Arb 4898 Basal sd
4980 TD 5027 was D&A - CO

J. G. McGEHEE

County **Gove** State **Kansas**
 Sec. **9** (Blk. **15** (Sur. **31W** Map No.
 Operator **D. R. Lauck et al. (was Trans. & Atl)**
 Well No. **1** Farm **Jones**

Elev. Location **NW NW NW**

0				

342 Ft. From **N** Line **NW**
330 Ft. From **W** Line Quarter
 1st. Report
 Completion **JUN 18 1952**
 Remarks **OWO**
 Spudding Date

COMPLETE

Drilg. Data **Oil well TD 5027**
Lans. 3690 Miss. 4330 Arb. 4898
Basal sd. 4980 TD 5027 CO to 4430
5" @ 4431 72/ 4284-4300 250 A
S/ 5 1/2 boph 5 hr. 1750 A S/ 250 bo
12 hr. S/ 25 boph P/ 150 bopd
Comp. 86 bopd 3% water

J. G. McGEHEE

KANSAS

Gove County ✓

Sec. 9 Twp. 15 R. 31W

Well No. #1 Jones Farm
D.R. LAUCK
Transwestern & Atlantic Company


Wildcat

342 Ft. from N. Line

_____ Ft. from S. Line

_____ Ft. from E. Line

330 Ft. from W. Line

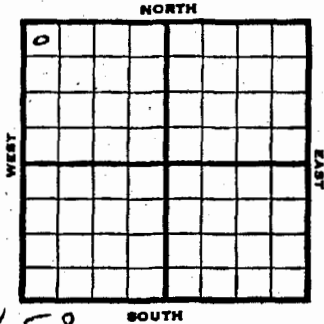

NW/c Elev. 2658

1944 REPORT

- 9/27 Rotary
- 10/4 10" @ 390
Drlg. 1010
- 10/11 Anhy 2110
Drlg. 2688
- 10/18 Drlg. 3632
- 10/25 Lans 3690
Drlg. 4346
- 11/2 Drlg. 4633
- 11/8 Drlg. 4738
- 11/16 Miss 4330
Drlg. 4895'
- 11/22 Arb. 4898
Basal Sd. 4980
TD 5027'

ABANDONED

O.W.W.O.

- 1952
- 4/16 Lans. 3690 Miss L 4330
Arb. 4898 Basal Sd 4980
TD 5027 was D&A - CO
- 4/25 CO to 4430' & set 5" csg @ 4430',
Perf. 72 holes--4284-4300', acidized
w/250 gals. Swbd. 6 bbls oil 1st. hour
and 9½ bbls. 2nd. hour. (Tel

OVER

1952

- 4/30 72/ 4284-4300 250 A S/ 6 boph
1750 A S/ 250 BO 12 hrs.
lost 4 hrs. 25 boph
- 5/7 NR
- 5/14 "
- 5/21 P/150 BOPD
- 5/28 NR
- 6/11 NR
- 6/18 Oil Well TD 5027
Lans. 3690 Miss 4330 Arb. 4898
Basal Sd 4980 TD 5027
CO to 4430 5" @ 4431
72/4284-4300 250 A
S/5½ boph 5 hr. 1750 A S/250 bo
12 hr. S/25 boph P/150 boph
Comp. 86 bopd 3% wtr.

COMPLETED

KANSAS

Gove County

O.W.W.O.

Section 9 Township 15 Range 31W

Well No. #1 Jones

Company D.R. Lauck
~~Transwestern & Atlantic~~

