

County Gove State Kansas

Sec. 21 (Blk. Twp.) 15 (Sur. Rge.) 31W Map No.

Operator Lafayette Oil Co.

Well No. 1 Farm Wies-Nichols

Elev. 2742 Location NW NW NW

					330 Ft. From N Line NW
					330 Ft. From W Line Quarter
					1st. Report
					Completion SEP 4 1952
					Remarks Wildcat
					Saline - Contr.
					Spudding Date 8-9-52

Drlg. Data D & A TD 4621

8" @ 260 Anhy 2194 DST 3784-3815
Failed DST 3779-3815 open $\frac{1}{2}$ hr.
 Rec. 20' mud 1050# Heeb. 3746
 Lens. 3770 B KC 4144 Marm. 4156
SCHLUMBERGER TOPS
 Anhy 2175 Heeb. 3741 Lens. 3762
 B KC 4134 Marm. 4174 DST 4366-98
 open $\frac{3}{4}$ hr. Rec. 15' mud O#
 Miss. 4446 TD 4621

D & A

J. G. McGEHEE

J. G. McGEHEE

Gove

KANSAS

Sec. 21 Twp. 15 R. 31W

Well No. #1 Wies-Nichols Farm

Lafayette Oil Co. Company

Salina Contractor

Wildcat


330 Ft. from N. Line

_____ Ft. from S. Line

_____ Ft. from E. Line

330 Ft. from W. Line

NW NW NW

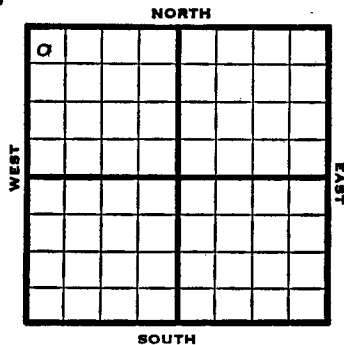

1952	Elev. 2742'	REPORT
8/13	Spud 8-9-52 8" @ 260' Anhy 1750' Drlg. 2000'	
8/20	Drlg. 3707'	
8/27	Heeb. 3746 Lans. 3770 DST 3784-3815 failed DST 3779-3815 1/2 hr. 20' M 1050# BKC 4144 Marm 4156 Drlg. 4225	
9/4	Spud 8-9-52 D&A TD 4621' 8" @ 260 Anhy 294 DST 3784-3815 failed DST 3779-3815 open 1/2 hr. rec. 20' mud 1050# Heeb. 3746 Lans. 3770 B KC 4144 Marm. 4156 Sch Tops: Anhy 2175 Heeb. 3741 Lans. 3762 B KC 4134 Marm. 4174 DST 4366-98 open 3/4 hr. rec. 15' mud O# Miss. 4446 TD 4621' D&A	
	ABANDONED	

Gove

KANSAS

Section 21 Township 15 Range 31 W

Well No. # 1 Wies-Nichols

Company Lafayette Oil Co.

