FORM 26 200 BKS. 2-44 PETROL

Pool Name Wildcat

Map No. KANSAS Sec. 24 Twp. 15 R. 31W


Well No. 1 Fick

Phillips Company

FIRST REPORT Contractor

NE SW

SECTION PLAT

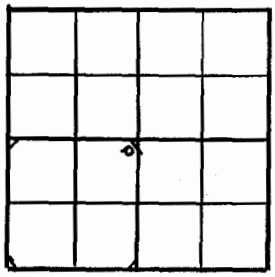

330 Ft. from N. Line

Ft. from S. Line

330 Ft. from E. Line

Ft. from W. Line

Gove County

Location X

Rig up

Drilling and Remarks:

RECORD

Cased in., ft.

Sand

Gas

Oil

Total Depth

PRODUCTION

1st 24 hrs. Nat.

1st 24 hrs. after shot

Gas Cu. Ft.

Dry Hole

Abandoned

Date

AUG 2 1944 19 S. J. LEWIS Scout

FORM 26 200 BKS 1-44 PETROL

Pool Name Wildcat

Map No. NW Sec. 24 Twp. 15 R. 31W


Well No. 1 Fick

Phillips Company

ABANDONED Contractor

NE SW

SECTION PLAT

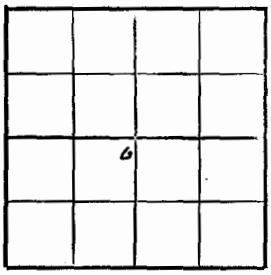

330 Ft. from N. Line

Ft. from S. Line

330 Ft. from E. Line

Ft. from W. Line

Gove

Location

Rig up

Drilling and Remarks:

Topeka 3462
Lans 3712
Miss 4407
Kinck 4852
Viola 4898
Simp 4947
Ark 4952

RECORD

Cased in., ft.

Sand

Gas

Oil

Total Depth 5001

PRODUCTION

1st 24 hrs. Nat.

1st 24 hrs. after shot

Gas Cu. Ft.

Dry Hole

Abandoned

Date

NOV 2 2 1944 19 S. J. LEWIS Scout

FORM 252-A
5M 3-44 PETROL

KANSAS

Gove

Sec. 24 Twp. 15 R. 31W

Well No. #1, Fick Farm

Phillips Company

Wildcat


330 Ft. from N. Line

Ft. from S. Line

330 Ft. from E. Line

Ft. from W. Line

NE SW Elev. 2638

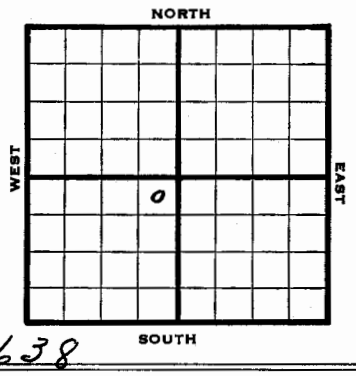

1944	REPORT
8/2	Location
8/9	"
8/16	13" @ 249 Drlg. 1770
8/23	Drlg. 3450
8/30	Drlg. 3515
9/8	4600 Rsg.
9/13	" "
9/21	" "
9/28	" "
10/4	" "
10/11	Test Whipstock
10/18	Set "
10/25	" "
11/2	Drlg. 4265
11/8	Drlg. 4687
11/16	TD 5001' S.D.
11/22	Topeka 3462
	Lans 3712
	Miss. 4407
	Kind 4892
	Viola 4898
	Simp. 4947
	Arb. 4952
	TD 5001

ABANDONED

KANSAS

FORM 51 5M 1-42 PETROL

Section 24 Township 15 Range 31W

Well No. 1 Fick

Company Phillips

