

MAP NO. _____ SEC. 29 TWP. 15S R. 31W

Map No. _____ Sec. _____ Twp. _____ R. _____

WELL NO. 1 2 3 4 5
Platoon 2415 COMPANY _____

Well No. _____ Farm _____


CONTRACTOR _____

Company _____

No well map

SECTION PLAT

_____ Ft. FROM N. LINE
_____ Ft. FROM S. LINE
_____ Ft. FROM E. LINE
_____ Ft. FROM W. LINE

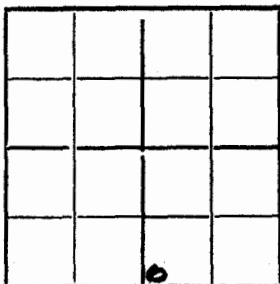


_____ Ft. from N. Line

_____ Ft. from S. Line

_____ Ft. from E. Line

_____ Ft. from W. Line

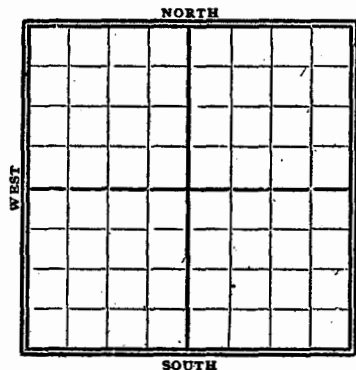

LOCATION _____

RECORD

CASED _____ IN. _____ FT.

SAND _____

GAS _____

OIL _____

TOTAL DEPTH 3840

PRODUCTION

1ST 24 HRS. NAT. _____

1ST 24 HRS. AFTER SHOT _____

GAS _____ Cu. Ft.

DRY HOLE

ABANDONED

DATE Mar 1923

SCOUT _____

1923

Date _____

REPORT

Gypsy Records
Abd 7'D 3840'

