


Saline KANSAS ✓


County Saline State Kansas
 Sec. 4 (Blk. Twp.) 15 (Sur. Rge.) 4W Map No.
 Operator Lewis Kitsis
 Well No. 1 Farm Phelps
 Elev. 1332 Location C S L SE SW

Sec. 4 Twp. 15 R. 4W
 Well No. #1 ~~Habiger~~ ^{Phelps} Farm
 Lewis Kitsis Company
 Shields Contractor

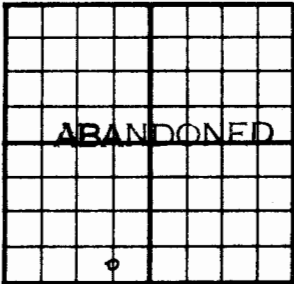

330 Ft. From S Line SW
 650 Ft. From E Line Quarter
 Ist. Report
 Completion SEP 9 1953
 Remarks
 Shields - Centr.
 Spudding Date 8-5-53

_____ Ft. from N. Line
 330 Ft. from S. Line
 650-660 Ft. from E. Line
 _____ Ft. from W. Line
 C S L SE SW

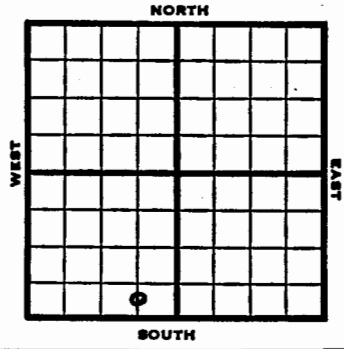

Drlg. Data D & A TD 3670
 8" @ 421 Heeb. 2203 Dodge 2221
 Doug. 2276 Br. lime 2365 Lans. 2415
 B KC 2756 Marm. 2759 Cherokee 2900
 Burgess 3058 Miss. 3068 Kh. 3388
 Meisner 3503 Hunton 3518 Maq. 3567
 TD 3670
 D & A

1953	Elev. 1332'	REPORT
8/5		Location
8/12		8" @ 421
		Drlg. 2092'
8/19		Miss 3067
		Drlg. 3271'
8/26		N.R.
9/2		D & A
9/9		Spud 8-5-53
		D&A
		TD 3670
		8" @ 421
		Heeb 2203, Dodge 2221, Doug 2276,
		Br lime 2365, Lans 2415, B KC 2756,
		Marm 2759, Cherokee 2900, Burgess
		3058, Miss 3068, Kh. 3388, Meisner
		3503, Hunton 3518, Maq 3567
		TD 3670
		D&A

J. G. McGEHEE

ABANDONED

FORM 51

Saline KANSAS

Section 4 Township 15 Range 4 W

Well No. # 1 Habiger Phelps

Company Lewis Kitsis

