

County **Saline** State **Kansas**  
 Sec. **15** (Bk. **15** (Sur. **4W** Map No.  
 Operator **Bay Pet**  
 Well No. **1** Farm **Royce**  
 Elev. Location **SE SE SE**  

|  |  |  |  |  |  |  |  |  |  |
|--|--|--|--|--|--|--|--|--|--|
|  |  |  |  |  |  |  |  |  |  |
|  |  |  |  |  |  |  |  |  |  |
**330** Ft. From **S** Line **SE**  
**330** Ft. From **E** Line Quarter  
 1st. Report **JUL 11 1951**  
 Completion  
 Remarks **Musgrove - Contr.**  
 Spudding Date  
 Drig. Data **Smolen - pool**

Location

J. E. TYRA

County **Saline** State **Kansas**  
 Sec. **13** (Bk. **15** (Sur. **4W** Map No.  
 Operator **Bay Pet.**  
 Well No. **1** Farm **Royce**  
 Elev. **1292** Location **SE SE SE**  

|  |  |  |  |  |  |  |  |  |  |
|--|--|--|--|--|--|--|--|--|--|
|  |  |  |  |  |  |  |  |  |  |
|  |  |  |  |  |  |  |  |  |  |
**330** Ft. From **S** Line **SE**  
**330** Ft. From **E** Line Quarter  
 1st. Report  
 Completion **AUG 1 1951**  
 Remarks **Smolen Pool**  
**Musgrove - Contr.**  
 Spudding Date **7-18-51**

Drig. Data **D & A** TD 3437  
 8" @ 385 Viola 3433 DST 3433-37  
 open 1 hr. Rec. 125' water TD 3437  
 D & A

J. E. TYRA

Saline

KANSAS

Sec. 13 Twp. 15 R. 4 W ✓

Well No. # 1 Royce Farm

Bay Pet. Company.

Musgrove Contractor

Smolen Pool


Ft. from N. Line

330 Ft. from S. Line

330 Ft. from E. Line

Ft. from W. Line

SE SE SE

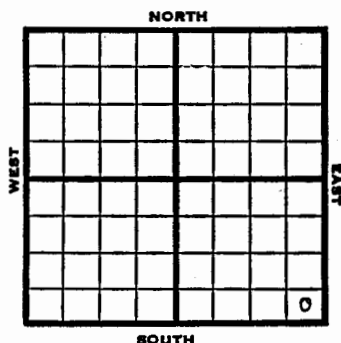

1951 Elev. 1292' REPORT

7/11 Location

8/1 Spud 7-18-51  
D & A TD 3437' 8" ● 385

Viola 3433'

DST 3433-37 open 1 hr. rec 125' water

TD 3437' D & A

**ABANDONED**

KANSAS

Section 13 Township 15 Range 4 W

Well No. # 1 Royce

Company Bay Pet.

