

Map No. KANSAS Sec. 15 Twp. 15 R. 4W
Well No. 1-Holmquist
Thralls et al. Company
Contractor

FIRST REPORT

SECTION PLAT

1020 Ft. from N. Line
Ft. from S. Line
300 Ft. from E. Line
Ft. from W. Line

	0		

Location _____
Rig up _____
Drilling and Remarks:

S.D. @ 1010'

RECORD

Cased _____ in., _____ ft.
Sand _____
Gas _____
Oil _____
Total Depth _____

PRODUCTION

1st 24 hrs. Nat. _____
1st 24 hrs. after shot _____
Gas _____ Cu. Ft.
Dry Hole _____
Abandoned _____

Date NOV 23 1924
M. A. BENEAR Scout

Map No. KANSAS Sec. 15 Twp. 15S R. 4W
Well No. 1-Holmquist
Thralls et al COMPANY
CONTRACTOR

SECTION PLAT

_____ FT. FROM N. LINE
_____ FT. FROM S. LINE
_____ FT. FROM E. LINE
_____ FT. FROM W. LINE

	0		

LOCATION _____
RIG UP _____
DRILLING AND REMARKS:

We show 1010 mark charging

RECORD

CASED _____ IN., _____ FT.
SAND _____
GAS _____
OIL _____
TOTAL DEPTH 1170

PRODUCTION

1ST 24 HRS. NAT. _____
1ST 24 HRS. AFTER SHOT _____
GAS _____ CU. FT.
DRY HOLE
ABANDONED


DATE 2/9 1926 SCOUT

Saline

Map No. Kans Sec. 15 Twp. 15 R. 4^W

Well No. 1- Holmquist Farm
Thralls etal Company

NORTH

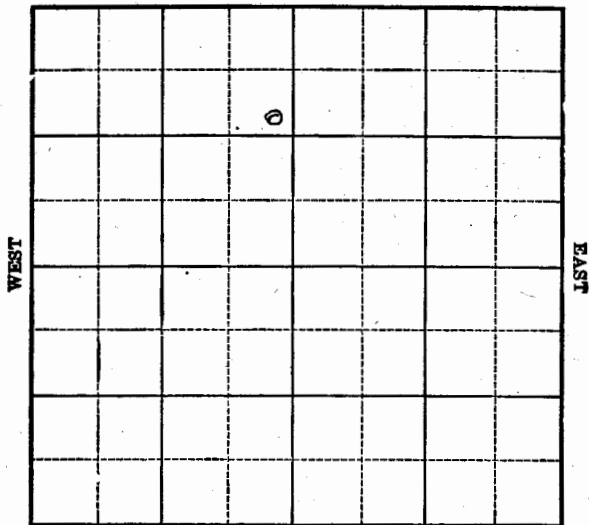

SOUTH

Location _____

Rig Up _____

Drilling Remarks

Drilling Remarks

RECORD

PRODUCTION

Cased _____ in. _____ ft.

1st 24 hrs. Nat. _____

Sand _____

1st. 24 hrs. after shot _____

Gas _____

Gas _____ cu. ft.

Oil _____

Dry Hole _____

Total Depth _____

Abandoned _____