

County Saline State Kansas
 Sec. 24 (Blk. 15) (Sur. 4^W) Map No.
 Operator Davis - Childs
 Well No. 4 Farm Dahlsten
 Elev. _____ Location C N L N $\frac{1}{2}$ SE

550 Ft. From N Line SE
1320 Ft. From E Line Quarter
 Ist. Report SEP 26 1951
 Completion _____
 Remarks _____
Sterling Drlg. - Contr.
 Spudding Date _____

Drlg. Data _____ Smolan Pool
 Location _____

J. E. TYRA

County Saline State Kansas
 Sec. 24 (Blk. 15) (Sur. 4^W) Map No.
 Operator Davis - Childs
 Well No. 4 Farm Dahlsten
 Elev. 1304 Location C N L N $\frac{1}{2}$ SE

330 Ft. From N Line SE
1320 Ft. From E Line Quarter
 Ist. Report _____
 Completion OCT 31 1951
 Remarks Smolan Pool
Sterling Drlg. - Contr.
 Spudding Date 9-29-51

Drlg. Data D & A TD 3431
13" @ 109 8" @ 345 Kh. 2198
Miss. 2876 Misener 3325 Hunton 3328
Maq. sh. 3361 Dol. 3428 TD 3431
D & A

J. E. TYRA

Saline

KANSAS

Sec. 24 Twp. 15 R. 4 W

Well No. # 4 Dahlsten Farm

Davis-Childs Company

Sterling Drlg. Contractor
Smolan Pool


330 Ft. from N. Line

_____ Ft. from S. Line

1320 Ft. from E. Line

_____ Ft. from W. Line

C NL N $\frac{1}{2}$ SE

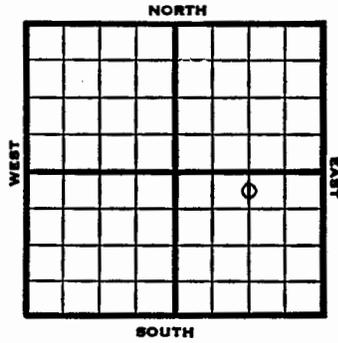


Saline

KANSAS

Section 24 Township 15 Range 4 W

Well No. # 4 Dahlsten

Company Davis-Childs

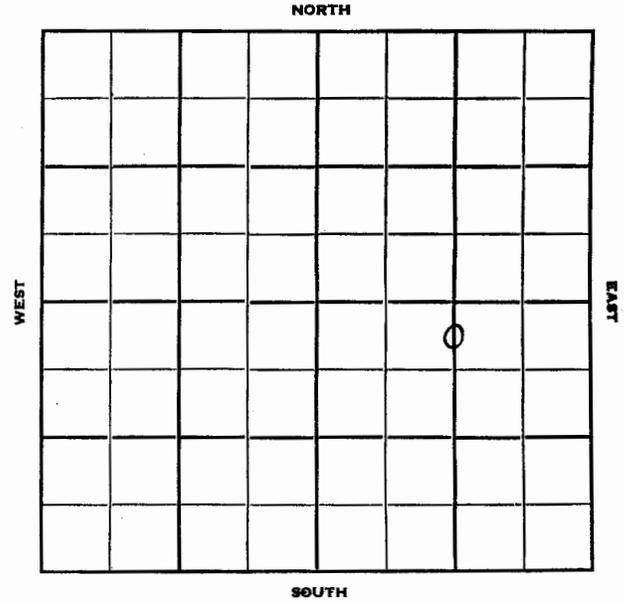

1951 Elev. 1304' REPORT

9/26 Location
 10/31 Spud 9-29-51
 D&A TD 3431
 13" @ 109
 8" @ 345
 KH 2198 Miss. 3876
 Misener 3325 Hunton 3328
 Mag. sh. 3361 Dol. 3428
 TD 3431
 D&A

ABANDONED