

County Saline State Kansas

Sec. 24 (Blk. Twp.) 15 (Sur. Rge.) 4W Map No.

Operator Davis - Childs

Well No. 8 Farm Dahlsten

Elev. Location SE SW SE

FIRST REPORT

330 Ft. From S Line SE

980 Ft. From W Line Quarter

1st. Report MAY 2 1951

Completion

Remarks Starling Drlg. - Contr.

Spudding Date 4-27-51

Drg. Data Smolan Pool

8" @ 320 drlg. 790

J. E. TYRRELL

County Saline State Kansas

Elev. 1293 (Bk.) 15 (Sur.) 4W Md.

Dip. Operator Davis - Childs

Casing No. 3 Farm Dahlsten

Location SE SW SE

Distance from S Line 330 Ft.
Distance from W Line 990 Ft. Quarter Section

Last Report

Date Completed JUN 20 1951

Remarks Smolan Pool
Sterling Drlg. - Contr.

Spudding Date 4-27-51

Drilling Data Oil well TD 3411

8" @ 320 Maq. 3408-11 5" @ 3408

TD 3411 S / 2 bopd 16' / 3407-10

S / 3 bopd Comp. 114 bopd 5% water

J. E. TYRA

Saline

KANSAS

Sec. 24 Twp. 15 R. 4 W ✓

Well No. # 3 Dahlsten Farm

Davis - Childs Company

Sterling Drlg. Contractor

Smolan Pool


Ft. from N. Line

330 Ft. from S. Line

Ft. from E. Line

990 Ft. from W. Line

SE SW SE

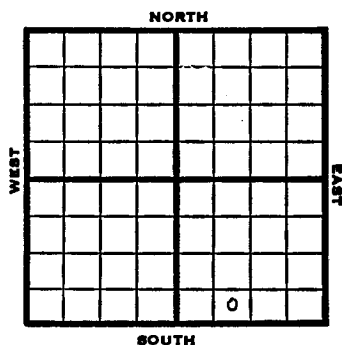


KANSAS

Section 24 Township 15 Range 4 W

Well No. # 3 Dahlsten

Company Davis-Childs

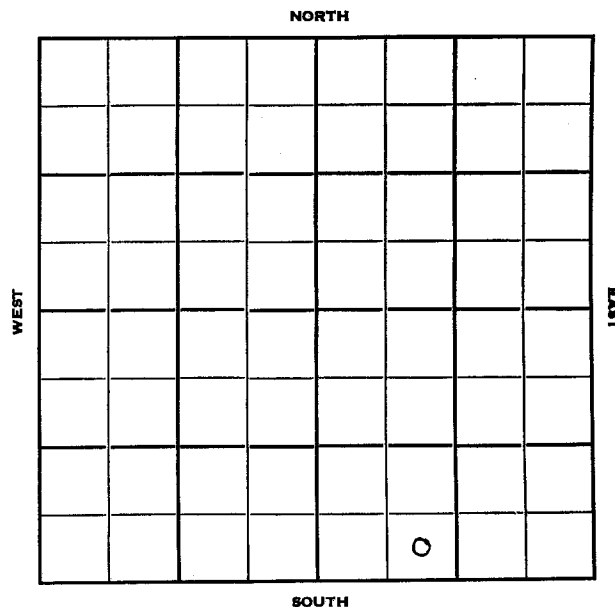

1951

Elev. 1293' REPORT

5/2

Spud 4-27-51

8" @ 320

Drlg. 790'

6/20

Spud 4-27-51

Oil Well TD 3411

8" @ 320

Maq 3408-11

5" @ 3408

TD 3411

S/2 boph 16/3407-10

S/3 boph Comp. 114 bopd 5% wtr

~~COMPLETED~~