

KANSAS

Saline

Sec. 24 Twp. 15 R. 4-W ✓

Well No. #2 Dahlsten Farm _____

Davis-Childs Company _____

Sterling Drlg. Contractor _____

Smolan


_____ Ft. from N. Line

990 Ft. from S. Line

330 Ft. from E. Line

_____ Ft. from W. Line

NE SE SE

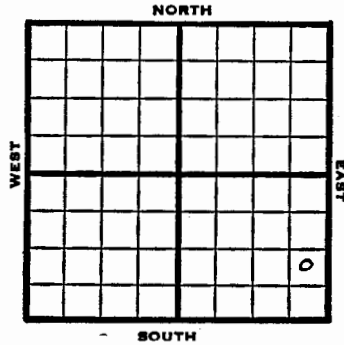

1951 Elev 1290' REPORT

1/3 Spud 12-30-50
8 5/8" @ 322
Drlg 970'

1/31 Spud 12/30/50
Oil well TD 3413
8-5/8" @ 322
Miss 2864 Kinderhook 3172 Misenor-
3302 Hunton 3304 Maq. 3346 Dol. 3409
TD 3413
5 1/2" @ 3409 FU 220' oil
Comp. 276 bopd

COMPLETED

Saline KANSAS

Section 24 Township 15 Range 4W

Well No. #2 Dahlsten

Company Davis-Childs

