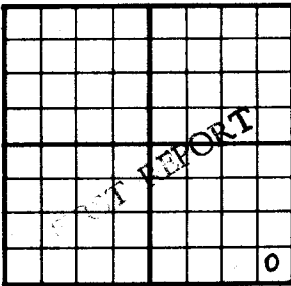


County Saline State Kansas
Sec. 24 (Bk. 15 (Sur. 4W Map No.)
(Twp.) (Rge.)
Operator Davis Childs
Well No. 1 Farm Delstere DAHLSTON
Elev. Location SE SE SE

										<u>330</u> Ft. From <u>S</u> Line <u>SE</u>
										<u>330</u> Ft. From <u>E</u> Line <u>Quarter</u>
										<u>1st. Report</u> <u>NOV 8 1957</u>
										<u>Completion</u>
										<u>Remarks</u>
										<u>Sterling Drlg. - Contr.</u>
<u>Drlg. Data</u>										<u>Spudding Date</u> <u>11-6-50</u>
<u>8" @ 325 WOC</u>										<u>Semi Wildcat</u>

J. E. TYRA

[illegible]

J. E. TYRA

KANSAS

Saline

Sec. 24 Twp. 15 R. 4-W ✓

Well No. #1 Dalstere DAHLSTON Farm

Davis Childs Company

Sterling Drlg. Contractor

Semi-WC


_____ Ft. from N. Line

330 Ft. from S. Line

330 Ft. from E. Line

_____ Ft. from W. Line

SE SE SE

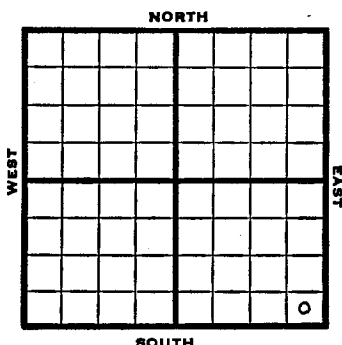

1950

Elev. 1291'

REPORT

11/8

Spud 11-5-50

8" @ 325

WOC

1951

1/10

Spud 11-5-50

Oil Well TD 3407

8" @ 325' Miss 2855 Hinderhook

Misenor 3308' 3168

Hunton 3311 Maq. 3342

Maq. dol. 3404

DST 3404-07 opn 35 min

Rec. 110' oil 60' hocm TD 3407

5" @ 3404 FU 1800' oil 12 hr.

Comp. 182 bopd

COMPLETED

KANSAS

Saline

Section 24 Township 15 Range 4-W

Well No. #1 Dalstere DAHLSTON

Company Davis Childs

