

Saline

Sec. 24 Twp. 15 R. KANSAS 4W

Well No. #1 Carlson Farm

Vaughn et al Company

V. D. Sidey - Contr. Contractor

Smolan Pool


990' Ft. from N. Line

Ft. from S. Line

330' Ft. from E. Line

Ft. from W. Line

SE NE SW

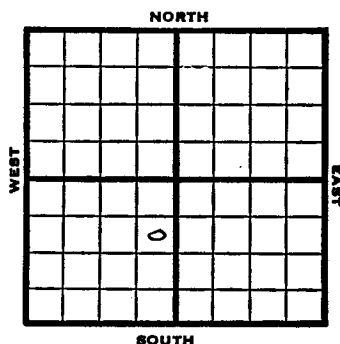


KANSAS

Section 24 Township 15 Range 4W

Well No. #1 Carlson

Company Vaughn - et al

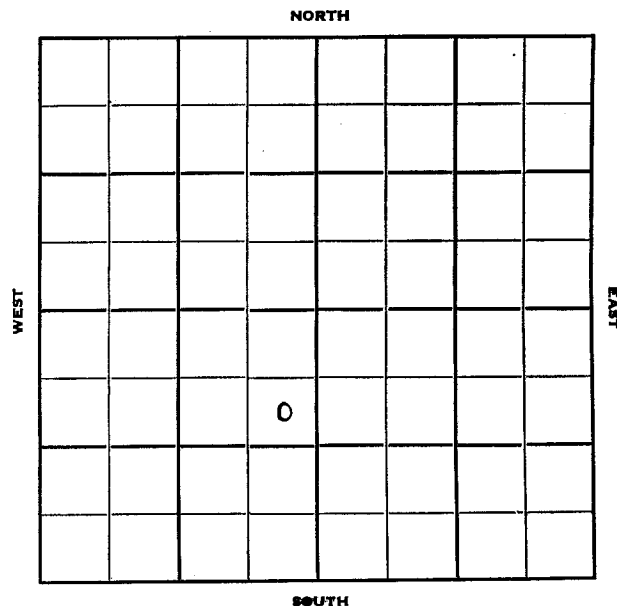

1951 Elev. 1299' REPORT

7/3 Spud 6-30-51
8" @ 346

7/18 Spud 6-30-51
D & A TD 3434' 8" @ 346'
Miss 2890' Kh 3197' Misenor 3329'
Hunton 3334' Maq. 3360' Dol. 3430'
DST 3431-34' TD open 28 min, rec 10'
mud.
D & A

ABANDONED