

County **Saline** State **Kansas**
 Sec. **24** (Blk. **15** (Sur. **4W** Map No.
 Operator **Musgrove Pet.**
 Well No. **1** Farm **Carlson**
 Elev. Location **SE SE NE**

FIRST REPORT									
									0

330 Ft. From **S** Line **NE**
330 Ft. From **E** Line Quarter
 Ist. Report **OCT 3 1951**
 Completion
 Remarks
Musgrove Pet. - Contr.
 Spudding Date

Drlg. Data **Smolan Pool**
R U R

J. E. TYRA

County **Saline** State **Kansas**
 Sec. **24** (Blk. **15** (Sur. **4W** Map No.
 Operator **Musgrove Pet.**
 Well No. **1** Farm **Carlson**
 Elev. **1302** Location **SE SE NE**

ABANDONED									
									0

330 Ft. From **S** Line **NE**
330 Ft. From **E** Line Quarter
 Ist. Report
 Completion **OCT 24 1951**
 Remarks **Smolan Pool**
Musgrove Pet. - Contr.
 Spudding Date **10-3-51**

Drlg. Data **D & A TD 3431**
8" @ 337 Viola 3425 DST 3425-29
open 1/2 hr. Rec. 7' so & wcm Miss. 2870
Kh. 3174 Misener 3326 Hunton 3330
Maq. 3357 TD 3431

D & A

J. E. TYRA

Saline

KANSAS

Sec. 24 Twp. 15 R. 4W

Well No. #1 Carlson Farm

Musgrove Pet. Company

Musgrove Pet. Contractor

Smolan Pool


Ft. from N. Line

330 Ft. from S. Line

330 Ft. from E. Line

Ft. from W. Line

SE SE NE

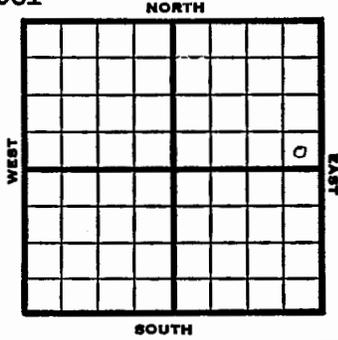


KANSAS

Section 24 Township 15 Range 4W

Well No. # 1 Carlson

Company Musgrove Pet.

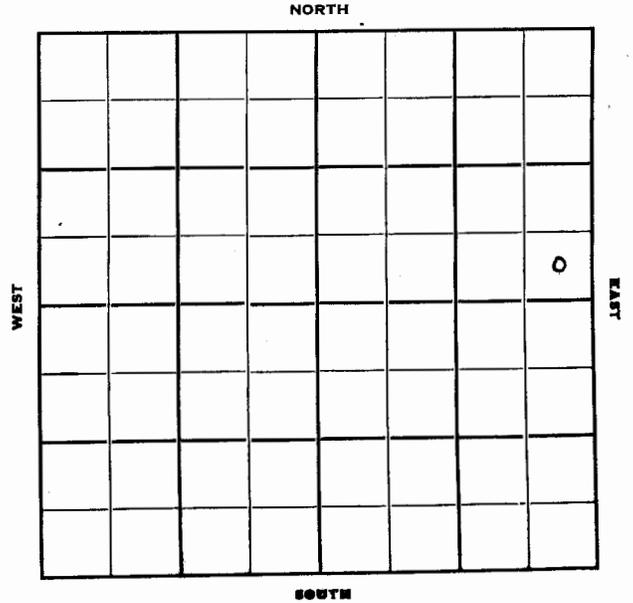

1951 Elev. 1302' REPORT

10/3 R U R
 10/24 Spud 10-3-51
 D&A TD 3431
 8" @ 337
 Viola 3425
 DST 3425-29 open 1/2 hr. rec. 7'
 SO&NCM
 Miss. 2870 Kh. 3174
 Misener 3326 Hunton 3330
 Mag. 3357
 TD 3431
 D&A

ABANDONED