

Saline

KANSAS
LW


Sec. 25 Twp. 15 R. 4W

Well No. #6
#5 Swenson Farm

Musgrove Pet. Company

Musgrove Contractor

990 Ft. from N. Line
Ft. from S. Line
990 Ft. from E. Line
Ft. from W. Line

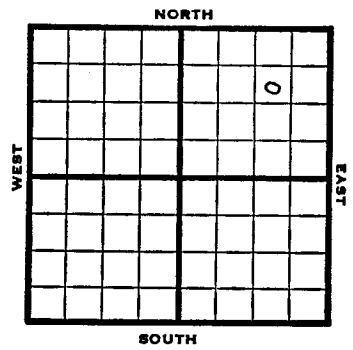


SW NE NE

Saline

Section 25 Township 15 Range 4W

Well No. #6
#5 Swenson

Company Musgrove Pet.

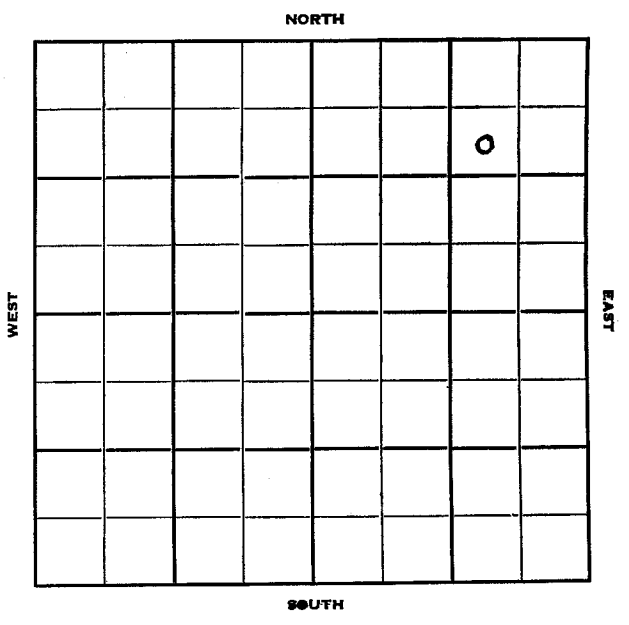

1952	Elev. 1291' REPORT
2/13	Location
2/20	C & P
3/5	"
3/11	8" @ 307' Drlg. 452'
3/19	Drlg. 2235'
3/25	Drlg. 3140'
4/1	Miss. 2849 KH 3169 Misner 3302 Htn. 3306 Mq. shale 3335 V. 3402-3409 RTD 4" @ 3402' WOC
4/9	CO to 3410 500 A S/6 BOPH tub & Roads
4/23	NR
4/30	"
5/7	"
5/14	Spud 3-4-52 Oil Well TD 3410 8" @ 307 Miss 2849 Kh. 3169 Misener 3302 Hunton 3306 Maq. 3335 Viola 3402 TD 3410 4" @ 3402 500 A S/6 boph Comp. 213 bopd
	COMPLETED