


County Saline State Kansas
 Sec. 25 (Blk. 15) (Sur. 4W) Map No.

Operator Musgrove Pet.

Well No. 6 Farm Swenson

Elev. _____ Location SW NW NE

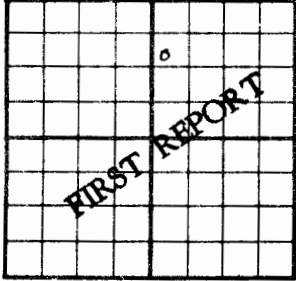

990 Ft. From N Line NE

330 Ft. From W Line Quarter

1st. Report FEB 13 1952

Completion _____

Remarks _____

Musgrove - Contr .

Spudding Date _____

Drig. Data _____

Location _____

Map No. _____ Sec. 25 Twp. 15 R. 4W

Well No. 5 Swenson

Musgrove Pet. Company

CORRECTION Contractor

SW NW NE


SECTION PLAT

990 Ft. from N. Line

_____ Ft. from S. Line

_____ Ft. from E. Line

330 Ft. from W. Line

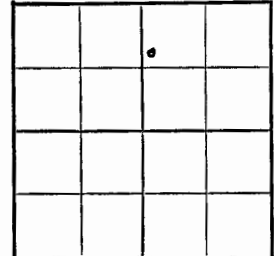

Saline County

Location _____

Rig up _____

Drilling and Remarks:

Reported
#6 Swenson

RECORD

Cased _____ in., _____ ft.

Sand _____

Gas _____

Oil _____

Total Depth _____

PRODUCTION

1st 24 hrs. Nat. _____

1st 24 hrs. after shot _____

Gas _____ Cu. Ft.

Dry Hole _____

Abandoned _____

Date


FEB 27 1952

19

J. G. McGEHEE

Scout

J. G. McGEHEE

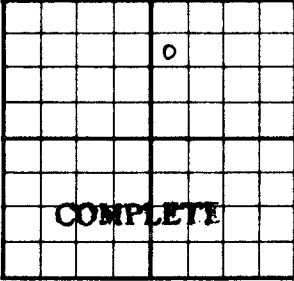County	Saline		State	Kansas	
Sec.	25	(Blk. Twp.)	15	(Sur. Rge.)	4W Map No.
Operator	Musgrove Pet.				
Well No.	5	Farm	Swenson		
Elev.	1295	Location	SW NW NE		
			990 Ft. From	N Line	NE
			330 Ft. From	W Line	Quarter
			1st. Report		
			Completion MAY 14 1952		
			Remarks		
			Musgrove - Contr.		
			Spudding Date 2-20-52		
Drig. Data	Oil well		TD 3414		
8" @ 335			Maq. 3412 TD 3414 4" @ 3413		
Misener 3320			Hunton 3324 Sylvian 3345		
Viola 3413			CO to 3414 B/ 15 boph		
500 A S/ 4 $\frac{1}{2}$ boph			Comp. 143 bopd 10% wtr		

J. G. McGEHEE

Saline

Sec. 25 Twp. 15 R. 4W

Well No. #5
#6 Swenson Farm

Musgrove Pet. Company

Musgrove Contractor


990 Ft. from N. Line

_____ Ft. from S. Line

_____ Ft. from E. Line

330 Ft. from W. Line

SW NW NE

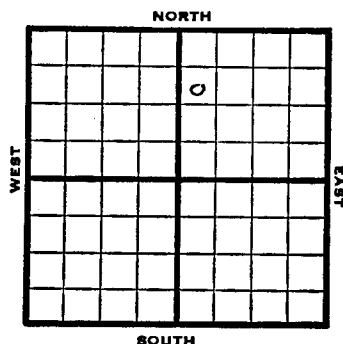

1952 Elev. 1295' REPORT

2/13 Location

2/20 C. & P.

3/5 Maq. Dol. 3412'

TD 3414'

4" @ 3413 WOC

3/11 Misner 3320 Htn 3324 Sylvan 3345

Maq. Dol 3412 V. 3413

TD 3414 4" @ 3413 WOCT

3/19 "

3/25 DP CO to 3414 B/ 15 gal oph
500 A S/ 4 1/2 boph for 4 hrs. tub.

4/9 nR

4/23 NR

4/30 *

5/7 "

5/14 Spud 2-20-52 Oil Well TD 3414

8" @ 335 Maq. 3412 TD 3414

4" @ 3413 Misner 3320

Hunton 3324 Sylvan 3345

Viola 3413 CO to 3414

B/15 boph 500 A S/4 1/2 boph

Comp. 143 bopd 10% wtr.

COMPLETED

Saline

Section 25 Township 15 Range 4 W

Well No. #5
#6 Swenson

Company Musgrove Pet.

